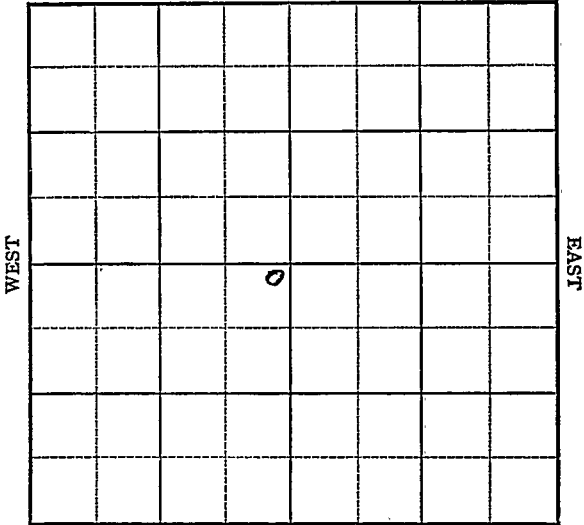


KANSAS

Section 25 Township 30 Range 38WWell No. 1 CarterCompany Hugoton Prod.Hugoton
NORTH


SOUTH

Grant

KANSAS

Sec. 25 Twp. 30 R. 38WWell No. #1 Carter FarmHugoton Prod. Company
Hugoton Pool (Burris, Cont.)100' Ft. from N. Line Ft. from S. Line100' Ft. from E. Line Ft. from W. Line

NE SW

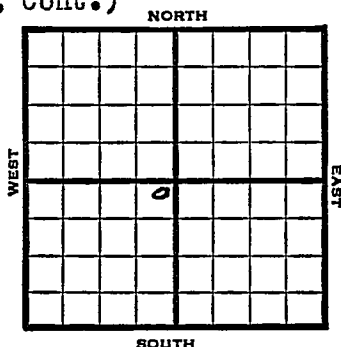

1949

Elev 3131'

REPORT

7/20 Location

7/27 "

8/3 10" @ 640'
Drlg. 1892'8/10 TD 2480'
7" @ 2470'

8/17 Drlg. 2512'

8/24 TD 2698-259' of 5" Perf Liner @2698'

8/31 TD 2698'

7" @ 2470'

259' of 5" Perf Liner @ 2698'

6,219,000 Gas

409# R Pr.

Comp

COMPLETED

Map No. _____ Sec. 25 Twp. 30 R. 38W

Well No. 1 Carter

Hugoton Prod. Company

Burris Contractor

NE SW


**FIRST REPORT
SECTION PLAT**

100 Ft. from N. Line

_____ Ft. from S. Line

100 Ft. from E. Line

_____ Ft. from W. Line

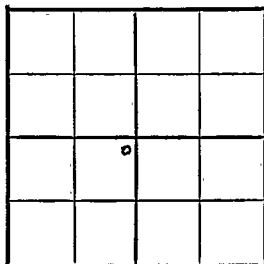

Grant County

Location X

Rig up _____

Drilling and Remarks: _____

RECORD

Cased _____ in., _____ ft.

Sand _____

Gas _____

Oil _____

Total Depth _____

PRODUCTION

1st 24 hrs. Nat. _____

1st 24 hrs. after shot _____

Gas _____ Cu. Ft.

Dry Hole _____

Abandoned _____

Date

JUL 20 1949 19

S. J. LEWIS Scout

Map No. ✓ Sec. 25 Twp. 30 R. 38W

Well No. 1 Carter

Hugoton Prod.

Company

COMPLETE

Contractor

NE SW


E12131
SECTION FLAT

100 Ft. from N. Line

 Ft. from S. Line

100 Ft. from E. Line

 Ft. from W. Line

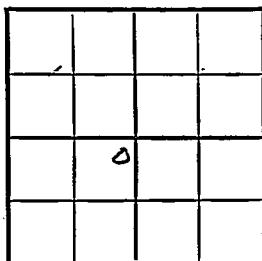

Grant County

RECORD

Location

Cased in., ft.

Rig up

Sand

Drilling and Remarks:

Gas

7" @ 2470

Oil

209' of 5" Perf

Total Depth 2698

Inc @ 2698

6, 219,000 lbs

PRODUCTION

1st 24 hrs. Nat.

1st 24 hrs. after shot

Gas Cu. Ft.

Dry Hole

Abandoned

Date

AUG 31 1949

19

S. J. LEWIS

Scout