

KANSAS


FORM 51 5M 6-46 PETROL

Barber

Section 26 Township 30 Range 15W

Well No. 2 Freeman "A"

Company Great Lake Carbon

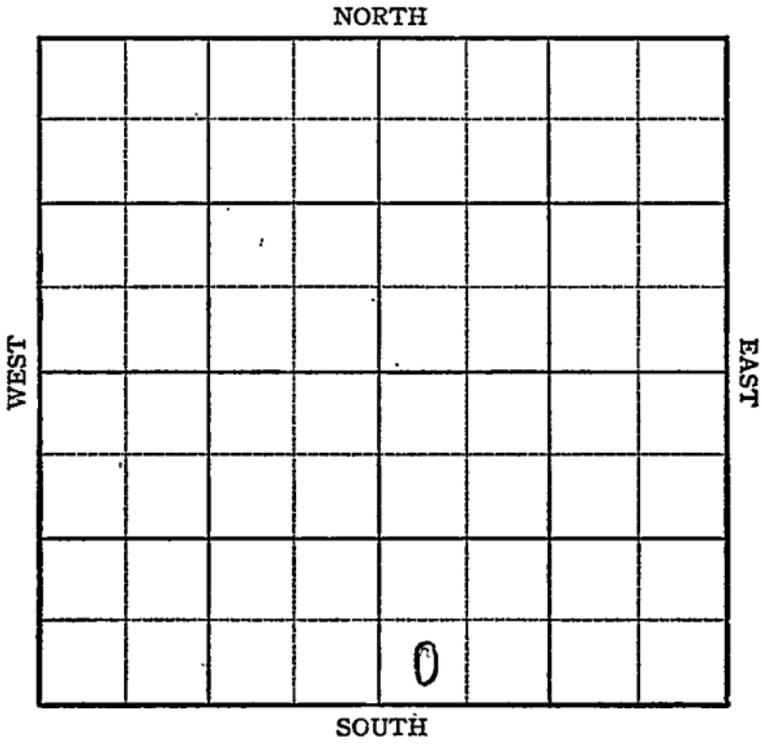

Sec. 26 Twp. 30 R. 15W

Well No. #2 Freeman "A" Farm

Great Lake Carbon Company

Sun City


_____ Ft. from N. Line

330 Ft. from S. Line

_____ Ft. from E. Line

330 Ft. from W. Line

SW SE

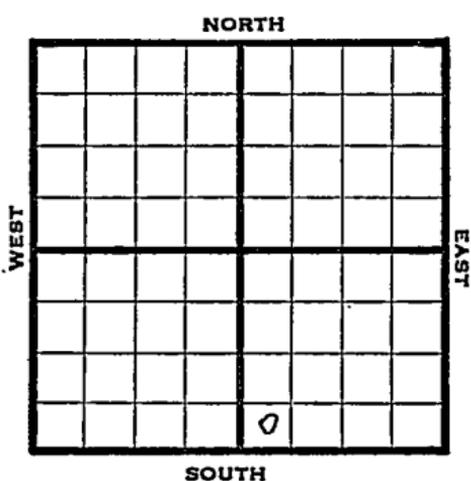

1946

1738

REPORT


- 7/3 RUR
- 7/9 Drlg 300'
- 7/16 8" @ 786
Drlg 2240'
- 7/23 Drlg 3055'
- 7/30 Drlg 4285'
- 8/6 Lans 3837-
Massey 4291
TD 4305
5" @ 4289 RUST
- 8/13 -" "
- 8/20 TD 4310-5000 acid
15 qts 4294-4304 CO
- 8/27 3500 acid CO
- 9/5 " "
- 9/10 " "
- 9/18 TD 4 320' CO
- 9/24 4323 CO
- 10/1 Drlg 4324'
- 10/8 TD 4324'
3500 acid
- 10/15 " "
- 10/22 " "

OVER

1946

10/30 Massey 4291'
5" @ 4289'
TD 4324'

ABANDONED

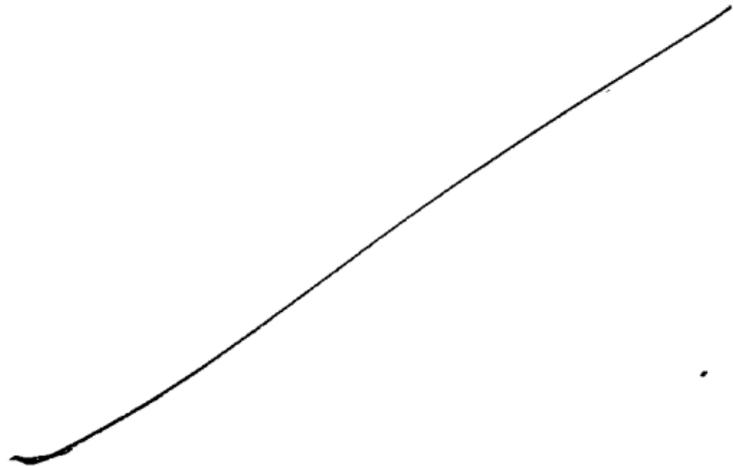

Spec. Small Maps	<i>[Handwritten mark]</i>
Cards	<i>[Handwritten mark]</i>
Tracing	<i>[Handwritten mark]</i>
France Map	<i>[Handwritten mark]</i>
Warborough Map	<i>[Handwritten mark]</i>
France Map	<i>[Handwritten mark]</i>
Ceological Dept.	<i>[Handwritten mark]</i>
France Plat Book	<i>[Handwritten mark]</i>

Kansas

Map No. 92 Sec. 26 Twp. 30 R. 15WWell No. 2 Freeman "A"Great Lakes Carbon Company**ABANDONED**

SW SE

Contractor

E. J. 1988

SECTION PLAT

_____ Ft. from N. Line

330 Ft. from S. Line

_____ Ft. from E. Line

330 Ft. from W. LineBarber County

Location _____

Rig up _____

Drilling and Remarks:

Messy 4281
5" @ 4289

RECORD

Cased _____ in., _____ ft.

Sand _____

Gas _____

Oil _____

Total Depth 4324

PRODUCTION

1st 24 hrs. Nat. _____

1st 24 hrs. after shot _____

Gas _____ Cu. Ft.

Dry Hole _____

Abandoned _____

Date

OCT 30 194619S. J. LEWIS

Scout

7-10


- Misc. Small Maps _____
- Cards *David* _____
- Tracing *MD* _____
- France Map *[check]* _____
- Scarborough Map *[check]* _____
- Pierce Map *[check]* _____
- Geological Dept. _____
- Pierce Flat Book _____