

KANSAS


Barber

FORM 51 5M 1-42 PETROL

Section 26 Township 30 Range 15-W

Well No. #1 Freeman "B"


Company Great Lakes Carbon

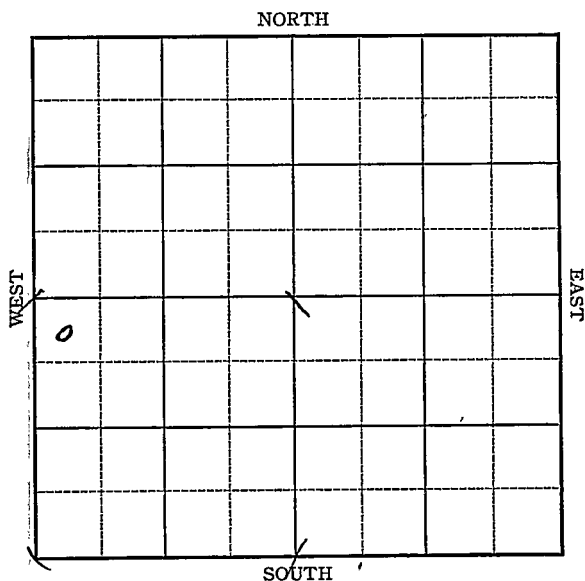

KANSAS

Barber

Sec. 26 Twp. 39 R. 15-W
Well No. #1 Freeman "B" Farm
Great Lakes Carbon Company

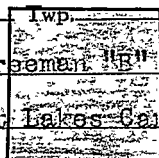


NORTH

330 Ft. from N. Line

 Ft. from S. Line

 Ft. from E. Line

330 Ft. from W. Line

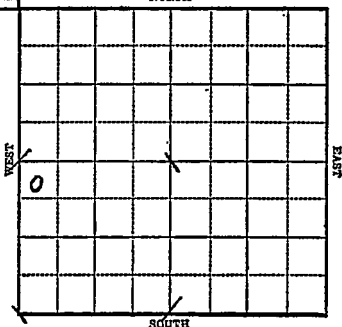

1943

Elev. 1794

R E P O R T

8/11

Location

8/18

"

8/25

Derrick

9/1

8" @ 882'

WOC

9/8

Drilg. 2890'

9/23

Lansing 3908

Topeka 3085

Pay 4344-50

5" - 4345

Drilled plugs

Drilled T.D. 4363

2000 feet oil in 1 hour

Than started flowing 3" stream of oil into pits

Shut in for tanks

Looks like a better well than the

Pryor & Lockhart in 6 se ne 27-30-15W

(Tel)

Running 3' higher on Lansing than Pryor &

Lockhart #1 Massey C SE NE 27-30S-15W a

Producer. (Mr. Woolley)

9/29

T.D. 4363' HFO 2000' oil in 1 hr.

10/7

Bomb Potential 8176 (Telegram)

OVER

1943

10/6 Lans 3910
5" @ 4345'
2000 acid
Bomb Pot. 8176
Max 3000
Gravity 36
T.D. 4363'

COMPLETED

Barber

KANSAS

Map No. 92 Sec. 26 Twp. 30 R. 15WWell No. 1 Freeman "B"

Great Lakes Carbon

Company

FIRST REPORT

Contractor

NW SW


330 Ft. from N. Line

Ft. from S. Line

Ft. from E. Line

330 Ft. from W. Line

SECTION PLAT

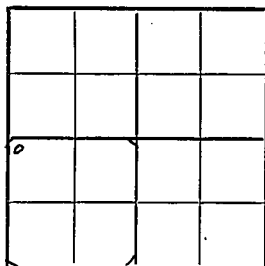

SUN CITY POOL

Location XXX

Rig up

Drilling and Remarks:

RECORD

Cased _____ in, _____ ft.

Sand _____

Gas _____

Oil _____

Total Depth _____

PRODUCTION

1st 24 hrs. Nat. _____

1st 24 hrs. after shot _____

Gas _____ Cu. Ft.

Dry Hole _____


Abandoned _____

Date

AUG 11 1943 19

S. J. LEWIS

Scout

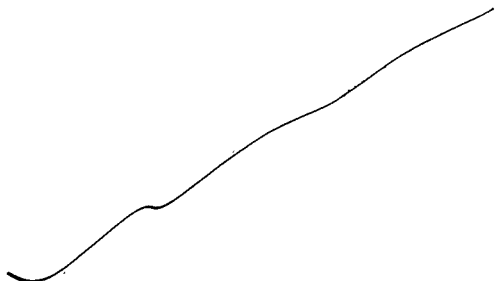

Misc. Small Maps	<i>Original</i>
Cards	<i>Beaumont</i>
Tracing	<i>W. L.</i>
France Map	<i>✓</i>
Scarborough Map	<i>✓</i>
Moody Map	<i>✓</i>
Geological Dept	<i>✓</i>
Moody Flat Book	

KANSAS

Map No. 72 Sec. 26 Twp. 30 R. 15WWell No. 1 Freeman "B"Great Lakes Carbon CompanyCOMPLETED Contractor

NW SW

SECTION PLAT

330 Ft. from N. Line Ft. from S. Line Ft. from E. Line330 Ft. from W. Line

0			

Sun City PoolLocation Rig up

Drilling and Remarks:

*have 3910.**5" @ 4345.**2000 acid**Bom & Pt. 5176**Max 3000**36 @ 4345*

RECORD

Cased in., ft.Sand Gas Oil Total Depth 4363


PRODUCTION

1st 24 hrs. Nat. 1st 24 hrs. after shot Gas Cu. Ft.Dry Hole Abandoned

Date

OCT 6 1943 19

S. J. LEWIS Scout

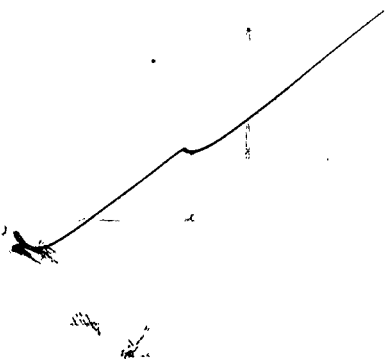

Misc. Card Index	<i>Om</i>
Cards	<i>Madge</i>
Tracing	<i>W. E. I.</i>
France Map	<i>✓</i>
Scarborough Map	<i>✓</i>
Pierce Map	<i>✓</i>
Ceological Dept.	<i>✓</i>
Pierre Plat Book	<i>✓</i>