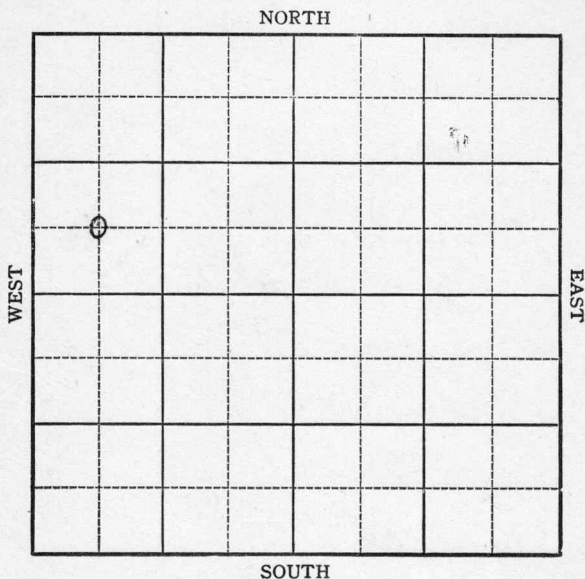


KANSAS

Barber

Section 26 Township 30 Range 15-WWell No. #2 MasseyCompany Pryor & Lockhart etal

KANSAS

Barber

Sec. 26 Twp. 30 R. 15-W

Well No. #2 Massey Farm


Pryor & Lockhart et al Company

Ft. from N. Line

660 Ft. from S. Line

Ft. from E. Line

660 Ft. from W. Line

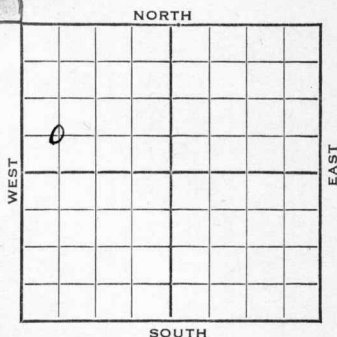

Elev. 1838

1943

REPORT

8/25

Location

9/1

"

9/8

"

9/15

"

9/22

"

9/29

"

10/6

"

10/13

"

10/20

"

10/27

12" @ 168'
Drlg. 1800'

11/3

Drlg. 3088'

11/10

Lans 3950
Drlg. 4188

11/17

No shows in Lans
Congl 4496
Viola 4549

11/24

Drlg. 4597'
Simp 4646
Drlg. 4712

12/1

PB Set whipstock
Fsg/

12/8

SD

12/15

Viols 4549
Simp 4646
TD 4712'

ABANDONED

KANSAS
Map No. 92 Sec. 26 Twp. 30 R. 15WWell No. 2 MasseyPryor & Lockhart etal CompanyFIRST REPORT Contractor


C SW NW

SECTION PLAT

Ft. from N. Line

660 Ft. from S. Line

Ft. from E. Line

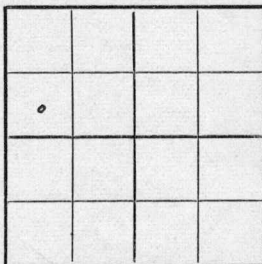660 Ft. from W. Line

Sun City Pool

Location X

Rig up _____

Drilling and Remarks:

RECORD

Cased _____ in., _____ ft.

Sand _____

Gas _____

Oil _____

Total Depth _____

PRODUCTION

1st 24 hrs. Nat. _____

1st 24 hrs. after shot _____

Gas _____ Cu. Ft.

Dry Hole _____

Abandoned _____

Date

AUG 25 1943 19 S. J. LEWIS Scout

KANSAS
 Map No. 92 Sec. 26 Twp. 30 R. 15W

Well No. 2 Massey

Pryor & Lockhart et al. Company

ABANDONED

Contractor

C SW NW

SECTION PLAT

o			

_____ Ft. from N. Line

660 Ft. from S. Line

_____ Ft. from E. Line

660 Ft. from W. Line

Sun City Pool

Location _____

Rig up _____

Drilling and Remarks:

Vista 4549
Sum 4646

RECORD

Cased _____ in., _____ ft.

Sand _____

Gas _____

Oil _____

Total Depth 4712

PRODUCTION

1st 24 hrs. Nat. _____

1st 24 hrs. after shot _____

Gas _____ Cu. Ft.

Dry Hole _____

Abandoned _____

Date

DEC 15 1943 19

S. J. LEWIS Scout