Form 51-5M 5-37 Petrol


Grant

KANSAS

Section 26 Township 30 Range 35-W

Well No. 1 - Julian

Company United Prod.

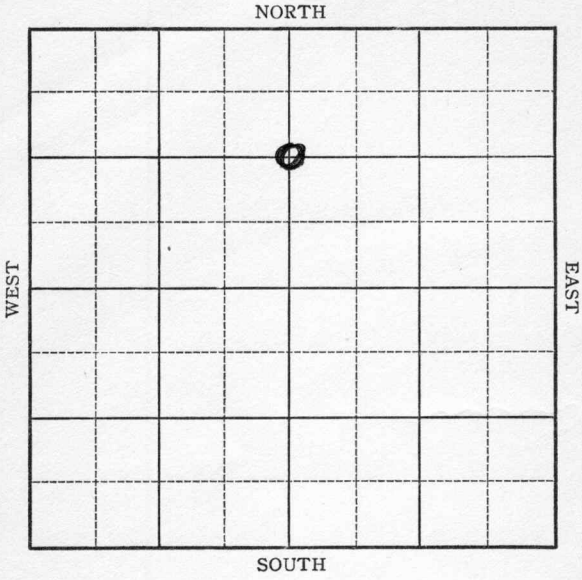

Form 252-A—5M—2-37—Palace Grant KANSAS

Sec. 26 Twp. 30 R. 35-W

Well No. #1 Julian Farm


United Prod. Company

1320 Ft. from N. Line

Ft. from S. Line

2640 Ft. from E. Line

Ft. from W. Line

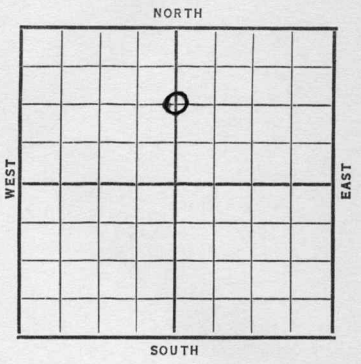

Date	REPORT
1937	
8/4	7" @ 2393' WOC
8/13	RUST.
8/18	7" @ 2393'.
	Sand 2393'.
	T.D. 2583'.
	Shot 80 qts.
	3½ M gas.
	COMPLETED

Form 26—1M Bks.—2-29

Grant KANSAS

Map No. _____ Sec. 26 Twp. 30 R. 35W

Well No. 1 – Julian

United Prod. Company

Contractor

FIRST REPORT


1320 Ft. from N. Line

_____ Ft. from S. Line

2640 Ft. from E. Line

_____ Ft. from W. Line

SECTION PLAT

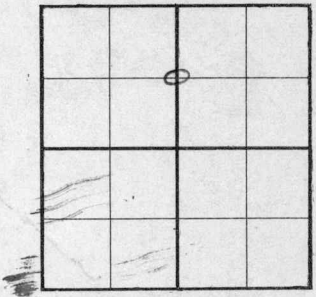

Location _____

Rig up _____

Drilling and Remarks:

7" 2393 WOC

RECORD

Cased _____ in., _____ ft.

Sand _____

Gas _____

Oil _____

Total Depth _____

PRODUCTION

1st 24 hrs. Nat. _____

1st 24 hrs. after shot _____

Gas _____ Cu. Ft.

Dry Hole _____

Abandoned _____

Date

AUG 4 - 1937 19

H. D. Hatfield Scout

Form 26—1M Bks.—2-29

Grant KANSAS

Map No. _____ Sec. 26 Twp. 30 R. 35W


Well No. 1 – Julian

United Prod. Company

Contractor

COMPLETED

SECTION PLAT

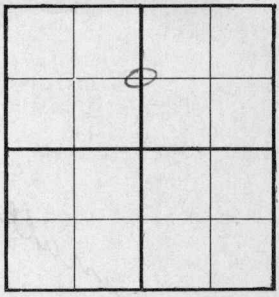

1320 Ft. from N. Line

_____ Ft. from S. Line

2640 Ft. from E. Line

_____ Ft. from W. Line

Location _____

Rig up _____

Drilling and Remarks:

Shot 80 qts

3½ Ni. 905

RECORD

Cased 7 in., 2393 ft.

Sand 2393

Gas _____

Oil _____

Total Depth 2583

PRODUCTION

1st 24 hrs. Nat. _____

1st 24 hrs. after shot _____

Gas _____ Cu. Ft.

Dry Hole _____

Abandoned _____

Date

AUG 18 1937 19____

H. D. Hatfield Scout