

KANSAS


Haskell

FORM 51 25M 3-49 PETROL

Section 26 Township 30 Range 34-W

Well No. #2 Smith

Company Lebosquet & Gillispie
Hugoton Pool

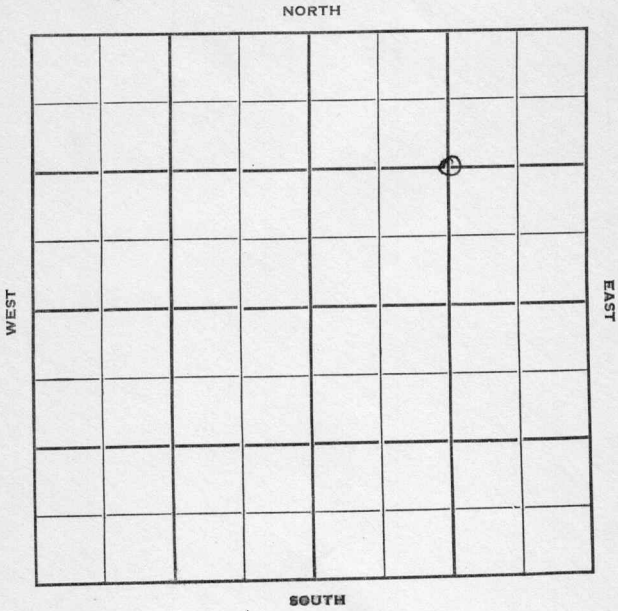

Haskell

KANSAS ✓

Sec. 26 Twp. 30 R. 34W

Well No. #2 Smith Farm

Lebosquet & Gillispie Company

Hugoton Pool Contractor


1320' Ft. from N. Line

 Ft. from S. Line

1320' Ft. from E. Line

 Ft. from W. Line

C NE

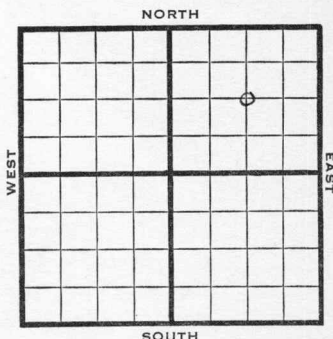

1949	Elev 2972'	REPORT
10/26	Location	
11/1	"	
11/9	"	
11/16	"	
11/23	"	
11/29	"	
12/7	"	
12/14	"	
12/21	"	
12/28	"	
1950		
3/8	TD 2677'	
	7"@ 2550'	
	27,917,000 CFGPD	
	Comp	
	COMPLETED	

Map No. _____ Sec. 26 Twp. 30 R. 34W

Well No. 2 Smith

Lebosquet & Gillispie Company

Contractor

C NE


**FIRST REPORT
SECTION PLAT**

1320 Ft. from N. Line

_____ Ft. from S. Line

1320 Ft. from E. Line

_____ Ft. from W. Line

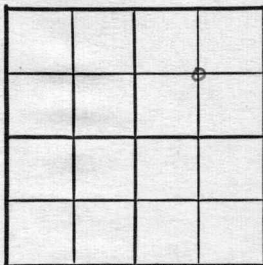

Haskell County

Location X

Rig up _____

Drilling and Remarks:

RECORD

Cased _____ in., _____ ft.

Sand _____

Gas _____

Oil _____

Total Depth _____

PRODUCTION

1st 24 hrs. Nat. _____

1st 24 hrs. after shot _____

Gas _____ Cu. Ft.

Dry Hole _____

Abandoned _____

Date

OCT 26 1949

19

S. J. LEWIS

Scout

Kansas

Map No. _____ Sec. 26 Twp. 30 R. 34WWell No. 2 SmithLebosquet & Gillispie Company

Contractor


C NE

EI. 2972
SECTION PLAT1320 Ft. from N. Line

_____ Ft. from S. Line

1320 Ft. from E. Line

_____ Ft. from W. Line

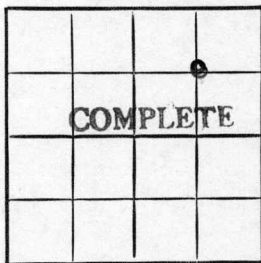Haskell County

Location _____

Rig up _____

Drilling and Remarks:

*7" @ 2550**27,917,000**CFGPD*

RECORD

Cased _____ in., _____ ft.

Sand _____

Gas _____

Oil _____

Total Depth 2677

PRODUCTION

1st 24 hrs. Nat. _____

1st 24 hrs. after shot _____

Gas _____ Cu. Ft.

Dry Hole _____

Abandoned _____

Date

MAR 8 1950 19**J. E. TYRA**

Scout