
DX 78-1

Kingman KANSAS

Section 26 Township 30 Range 9 W

Well No. # 1 Holcomb "A"

Company Pickrell Drlg.

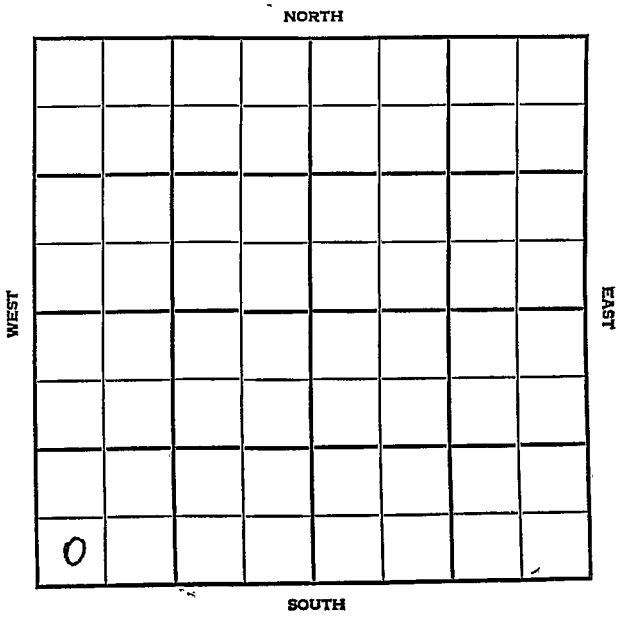

Kingman KANSAS

SEC.	TWP.	R.
26	30	9W

WELL NO.

1 Holcomb "A" FARM

COMPANY

Pickrell Drlg.

CONTRACTOR

Co. Tools

Wildcat


_____ Ft. from N. Line

330 Ft. from S. Line

_____ Ft. from E. Line

330 Ft. from W. Line

SW SW SW

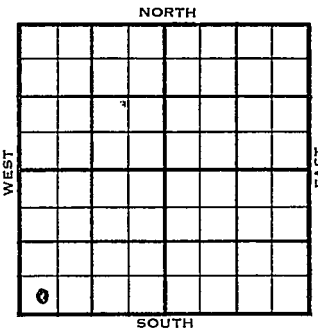

1955	ELEVATION 1662'	REPORT

2/23 MIR

4/20 Spud 2-22-55 SI gas well TD 4420
8" @ 160 Doug. 3478 Lans 3632'
Miss 4346'
DST 4351-70 open 1 hr gas in 6½ min
rec 55' GCM 990#
DST 4380-4420 open 1 hr rec 30' mud 0#
TD 4420' 5" @ 4413 CO to 4375
80/4350-70 150,000 CFG sd-oil-frac
Comp. SI gas well 1,500,000 CFGPD

COMPLETED

DX-78

FORM 275 FOR SALE BY KANSAS BLUE PRINT CO.


County Kingman State Kansas

Sec. 26 (Blk. Twp.) 30 (Sur. Rge.) 9W Map No.

Operator Pickrell Drlg.

Well No. 1 Farm Holcomb "A"

Elev. 1662 Location SW SW SW

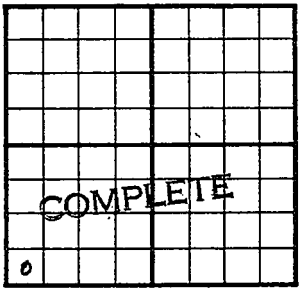

330 Ft. From S Line SW

330 Ft. From W Line Quarter

1st. Report

Completion APR 2 0 1955

Remarks Wildcat

Co. tools

Spudding Date 2-22-55

Drlg. Data SI gas well TD 4420

8" @ 160 Doug. 3478 Lans. 3632

Miss. 4346 DST 4351-70 open 1 hr.

gas in 6½ min. Rec. 55' gcm 990#

DST 4380-4420 open 1 hr. Rec. 30' mud

0# TD 4420 5" @ 4413 CO to 4375

80/ 4350-70 150,000 cfg sd-oil-frac

Comp. SI gas well 1,500,000 cfgpd

FABEN GILSTRAP

FORM 275 FOR SALE BY KANSAS BLUE PRINT CO.

County Kingman State Kansas

Sec. 26 (Blk. Twp.) 30 (Sur. Rge.) 9W Map No.

Operator Pickrell Drlg.

Well No. 1 Farm Holcomb "A"

Elev. Location SW SW SW



330 Ft. From S Line SW

330 Ft. From W Line Quarter

1st. Report FEB 2.3 1955

Completion

Remarks Co. tools

Spudding Date

Drlg. Data Wildcat

M I R

FABEN GILSTRAP