

Kingman

KANSAS


DX 78-1

Section 26 Township 30 Range 8W

Well No. #4 Boyle "D"

Company Pickrell Drlg.

NORTH

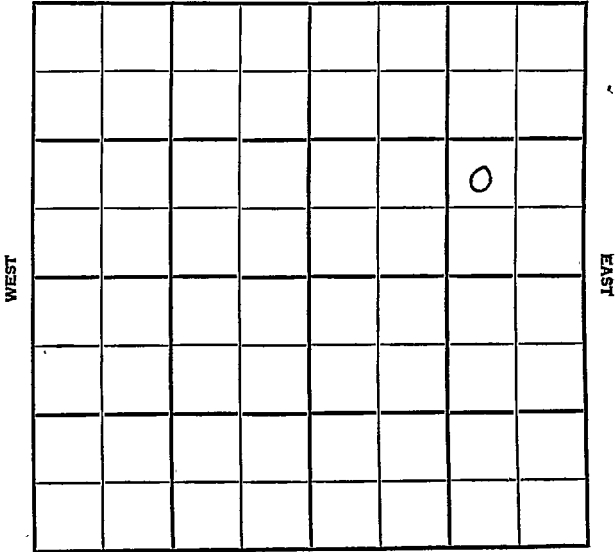

SOUTH



