


Section 26 Township 30 Range 8W

Well No. 2 Boyle "D"

Company Pickrell Drlg.

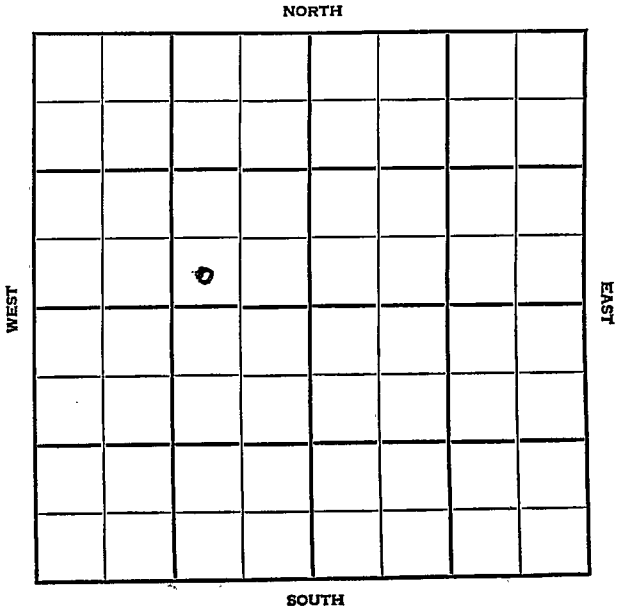

Kingman KANSAS

SEC.	TWP.	R.
26	30	8W


WELL NO. 2 Boyle "D" FARM

COMPANY Pickrell Drlg.

CONTRACTOR Pickrell

Spivey Pool

_____ Ft. from N. Line
 330 _____ Ft. from S. Line
 990 _____ Ft. from E. Line
 _____ Ft. from W. Line

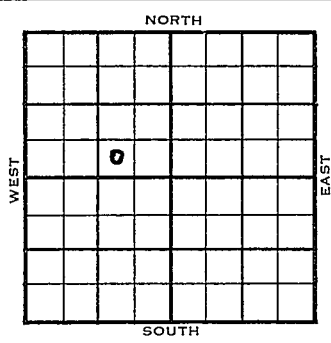

SW SE NW

1954	ELEVATION 1615'	REPORT
------	--------------------	--------

9/8 Spud 9-3-54
 8" @ 160'

11/10 Spud 9-3-54
 Oil Well
 TD 4435'
 8" @ 160'
 Miss 4320'
 DST 4331'-45' opn 1 hr, rec 95' gcm
 1140#
 DST 4345'-65' opn 1 hr, rec 150' o &
 gcm 1120#
 DST 4365'-95' opn 1 hr, rec 150' o &
 gcm 310' ho & gcm 1140#
 TD 4435'
 5" @ 4433'
 CO to 4403'
 40/ 4362-72 s-oil-frac S & F 10.83
 bfph 40% Wtr. 12 hr.
 Comp F/ 170 bopd. 50% Wtr.

COMPLETED

