

KANSAS

FORM 51 5M 4-41 PETROL


Kingman

Section 26 Township 30 Range 5-W

Well No. #1 Banta

Company Magnolia

Wildcat

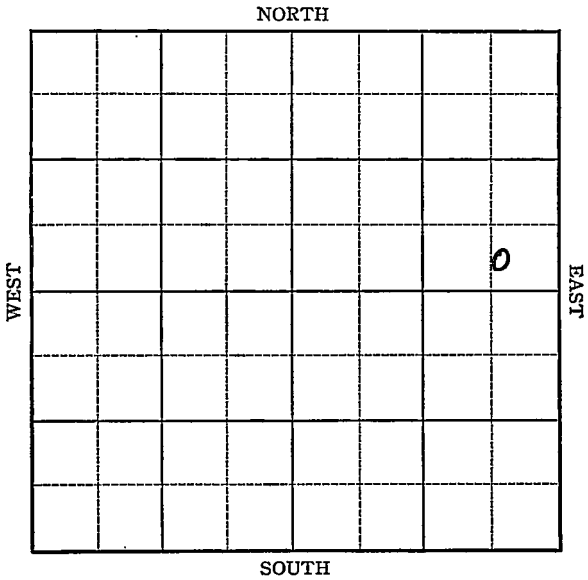


Map No. 37 Sec. 26 Twp. 30 R. 5WWell No. 1 BantaMagnolia Company~~FIRST REPORT~~ Contractor

SECTION PLAT

C S L S E NE

 Ft. from N. Line230 Ft. from S. Line600 Ft. from E. Line Ft. from W. Line

WILDCAT

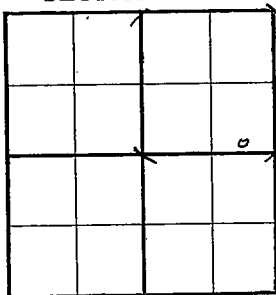Location Rig up

Drilling and Remarks:

DERRICK

RECORD

Cased in., ft.Sand Gas Oil Total Depth

PRODUCTION

1st 24 hrs.-Nat. 1st 24 hrs. after shot Gas Cu. Ft.Dry Hole Abandoned

Date

MAY 27 1941
19S. J. LEWIS Scout

Map No. 37 Sec. 26 Twp. 30 R. 5W

Well No. 1 Banta

Magnolia Company

ABANDONED Contractor

SECTION PLAT

C S L SE NE

 Ft. from N. Line

230 Ft. from S. Line

600 Ft. from E. Line

 Ft. from W. Line

			o

WILDCAT

RECORD

Location

Cased in., ft.

Rig up

Sand

Drilling and Remarks:

Gas

Cr & 4714
Noe hole

Oil

Total Depth 4774

PRODUCTION

1st 24 hrs. Nat.

1st 24 hrs. after shot

Gas Cu. Ft.

Dry Hole

Abandoned

Date

JUN 25 1941 19

S. J. LEWIS Scout