

Grant


KANSAS

Form 51-5M 5-37 Petrol

Section 26 Township 30 Range 37-W


Well No. 1 - Towler

Company Panhandle Eastern

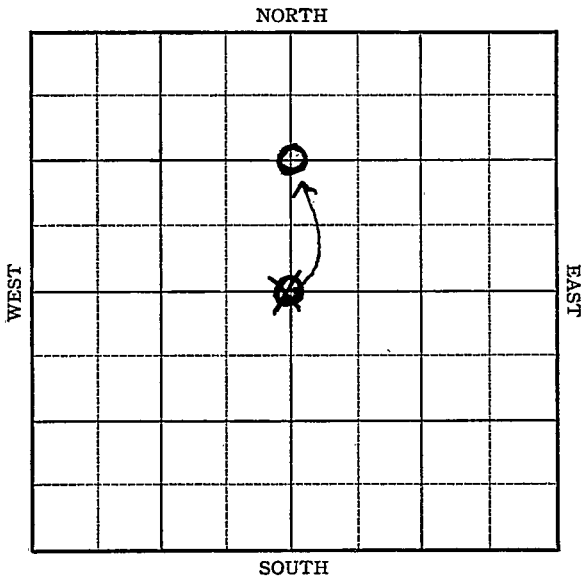

Sec. 26 Twp. 30 R. 37-WWell No. #1 Fowler FarmPanhandle Eastern Company

NORTH

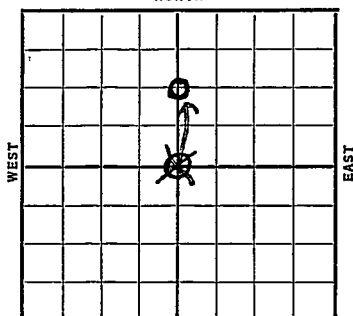

SOUTH

1320~~2640~~

Ft. from N. Line

Ft. from S. Line

2640

Ft. from E. Line

Ft. from W. Line

Date

REPORT

1937

8/4

7" @ 2372'

Ø 2530'

8/13

2 B.W. 2845-50'. P.B. 2581'.

8/18

7" @ 2372'.

Sand 2372'.

T.D. 2850'.

P.B. 2581'.

2 M gas--Natural.

Shot 180 qts.

5,328,000 C.F. gas.

COMPLETED

Grant **KANSAS**Map No. _____ Sec. 26 Twp. 30 R. 37^WWell No. 1 - FowlerPanhandle Eastern Company


Contractor _____

FIRST REPORT**SECTION PLAT**2640 Ft. from N. Line

_____ Ft. from S. Line

2640 Ft. from E. Line

_____ Ft. from W. Line

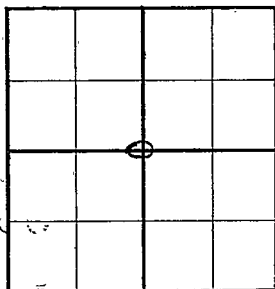

Location _____

Rig up _____

Drilling and Remarks:

17" 2372φ - 2530**RECORD**

Cased _____ in., _____ ft.

Sand _____

Gas _____

Oil _____

Total Depth _____

PRODUCTION

1st 24 hrs. Nat. _____

1st 24 hrs. after shot _____

Gas _____ Cu. Ft.

Dry Hole _____

Abandoned _____

Date

AUG 4 - 1937 19H. D. Hatfield Scout

Grant **KANSAS**Map No. _____ Sec. 26 Twp. 30 R. 37^wWell No. 1 - FowlerPanhandle Eastern Company

Contractor _____

CORRECTION


1320 Ft. from N. Line

_____ Ft. from S. Line

2640 Ft. from E. Line

_____ Ft. from W. Line

SECTION PLAT

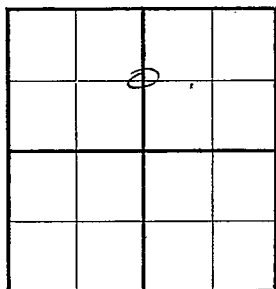

Location _____

Rig up _____

Drilling and Remarks:

*1st reported as
center of section
but loc. was
changed to C N $\frac{1}{2}$*

RECORD

Cased _____ in., _____ ft.

Sand _____

Gas _____

Oil _____

Total Depth _____

PRODUCTION

1st 24 hrs. Nat. _____

1st 24 hrs. after shot _____

Gas _____ Cu. Ft.

Dry Hole _____

Abandoned _____

Date

AUG 18 1937

19

H. N. Hatfield

Scout

KANSAS

Map No. No Map Sec. 26 Twp. 30 R. 37 W.Well No. 1 - FowlerPanhandle Eastern Company

Contractor

COMPLETED

SECTION PLAT

1320 Ft. from N. Line (See correction, Ticker)

_____ Ft. from S. Line

2640 Ft. from E. Line

_____ Ft. from W. Line

Location _____

Rig up _____

Drilling and Remarks:

P.B. 2581
2 M gas - Naturalshot 180 gts5,328,000 C.F.

RECORD

Cased 7 in., 2372 ft.Sand 2372

Gas _____

Oil _____

Total Depth 2850

PRODUCTION

1st 24 hrs. Nat. _____

1st 24 hrs. after shot _____

Gas _____ Cu. Ft.

Dry Hole _____

Abandoned _____

Date

AUG 18 1937-19H. D. Hatfield

Scout