


Section 26 Township 30 Range 39 W

Well No. 1 Citizens State

Company Stanolind Oil

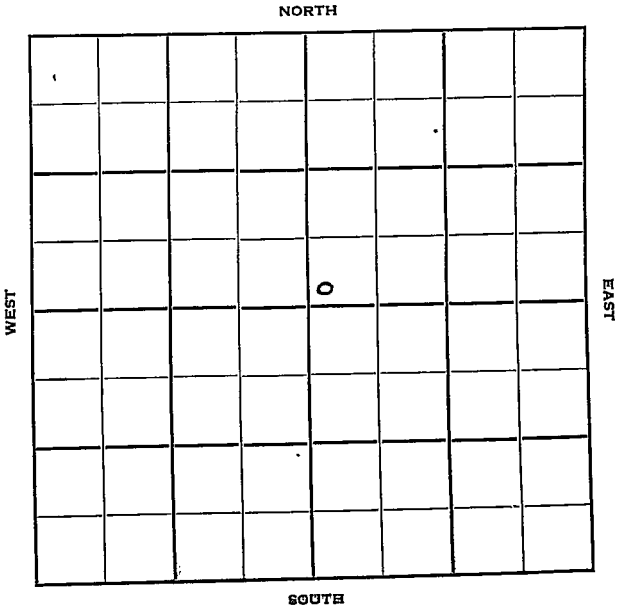

Stanton

KANSAS

Sec. 26 Twp. 30 R. 39W ✓

Well No. #1 Citizens State Farm

Stanolind Oil

Company

Contractor

Ft. from N. Line

150


Ft. from S. Line

Ft. from E. Line

150

Ft. from W. Line

150 N & E of C

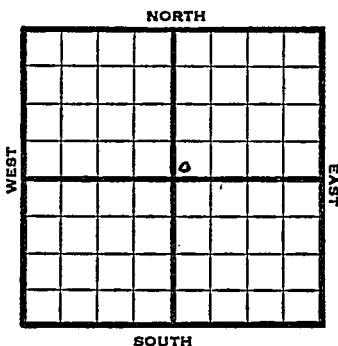

1950

Elev 3147

REPORT

5/17

Location

6/28

10" @ 537

7" @ 2519

TD 2568

Her 2340-92

Win 2410-48

Ft Riley 2476-2514

144/2478-2514, 120/2410-40, 88/2426-48

120/2340-70, 72/2374-92

28000 acid

Comp 11,150,000 gas 406#

Completed

COMPLETED

Kansas


Map No. _____ Sec. 26 Twp. 30 R. 39W

Well No. 1 Citizens State

Stanolind Oil _____ Company

Contractor

150 N & E of C

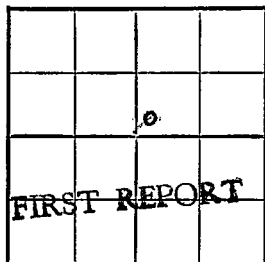SECTION PLAT

_____ Ft. from N. Line

_____ Ft. from S. Line

_____ Ft. from E. Line

_____ Ft. from W. Line

Stanton

Location X

Rig up _____

Drilling and Remarks:

RECORD

Cased _____ in., _____ ft.

Sand _____

Gas _____

Oil _____

Total Depth _____

PRODUCTION

1st 24 hrs. Nat. _____

1st 24 hrs. after shot _____

Gas _____ Cu. Ft.

Dry Hole _____

Abandoned _____

Date

MAY 17 1950

19

J. E. TYRA Scout

Serial

Unit No. _____

Wall Map

Section

Page

Section List

1. From 1st Line _____
2. From 2nd Line _____
3. From 3rd Line _____
4. From 4th Line _____

Section

Location

Remarks

Date and Signature

Scout Cards 1
Land Small Map
Land Wall Map
Tracings
France Map
Pierce Map
Misc.

1951

Date

Page

Map No. _____ Sec. 26 Twp. 30 R. 39W

Well No. 1 Citizens State

Stanolind _____ Company

_____ Contractor

SW NE


El. 3147
SECTION PLAT

_____ Ft. from N. Line

150 Ft. from S. Line

_____ Ft. from E. Line

150 Ft. from W. Line

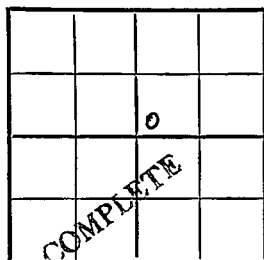

Stanton County

Location _____

Rig up _____

Drilling and Remarks:

10" C 537

7" C 2519

TD 2568

Her. 2340-92

Win. 2410-48

Ft. Riley 2476-2514

144/ 2478-2514

RECORD

Cased _____ in., _____ ft.

Sand _____

Gas _____

Oil _____

Total Depth 2568

PRODUCTION

1st 24 hrs. Nat. _____

1st 24 hrs. after shot _____

Gas _____ Cu. Ft.

Dry Hole _____

Abandoned _____

Date

JUN 28 1950
19

J. E. TYRA Scout


