

Kiowa

KANSAS


SECTION 27 TOWNSHIP 30S RANGE 16W

WELL NO. #1 Robbins "J"

COMPANY Shell 25%, Gulf Oil 75%

NORTH

NE SW

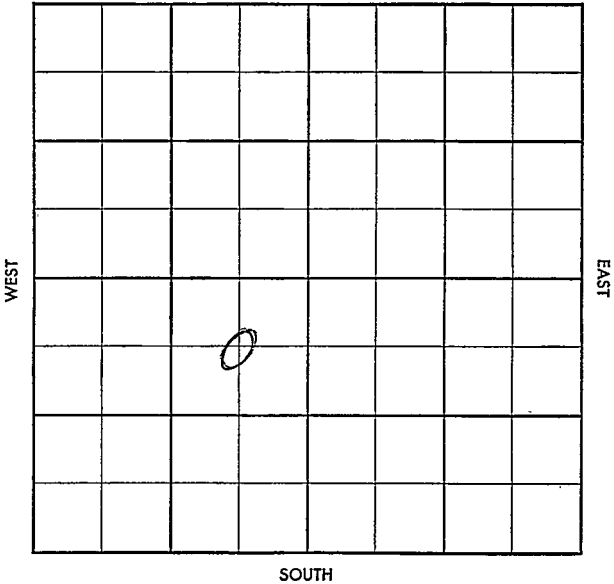

5-513-A

CO. Kiowa ELEV. 1835'

SEC. 27 TWP. 30 RGE. 16W

COMPANY Shell (25%), NO. 1

Gulf Oil Corp. (75%)

FARM Robbins "J"

LOC. NE SW (90' Sq. of)

COMPLETE
FEB 19 '58

<u>LKC 4036</u>	
<u>M chest 4608</u>	
<u>TD 4818</u>	

GEOL. _____
CONTR. Falcon-Seaboard #20

POOL Glick

SPUD 1/6/58

8" @ 411 w/325, WOC TD

415. JAN 15 '58 Ø 4101

JAN 22 '58 crd. 4627-52

see 25'

Log to top BL 4019

LKC 4035 M chest

4606 Kind 4752 U 4780

4 1/2 4818 150 184/4620-66

JAN 29 '58 184/4620 from 40x40

1/2 6. F10 Ld + g 2.820 mil

16/64" chk FTP 1180 CP 1325

FEB 5 '58 FEB 12 '58 F10 14,500 mil

+ 1.5 B Distillate 5.56 BLDW

5 hrs FEB 19 '58 Ca of F10 14,500

mil + 1.5 B distillate 5.56

B Ld W

CO. LSE. NO. SEC. TWP. RGE.