


Section 27 Township 30 Range 15W

Well No. #1 Massey D

Company Great Lakes Carbon

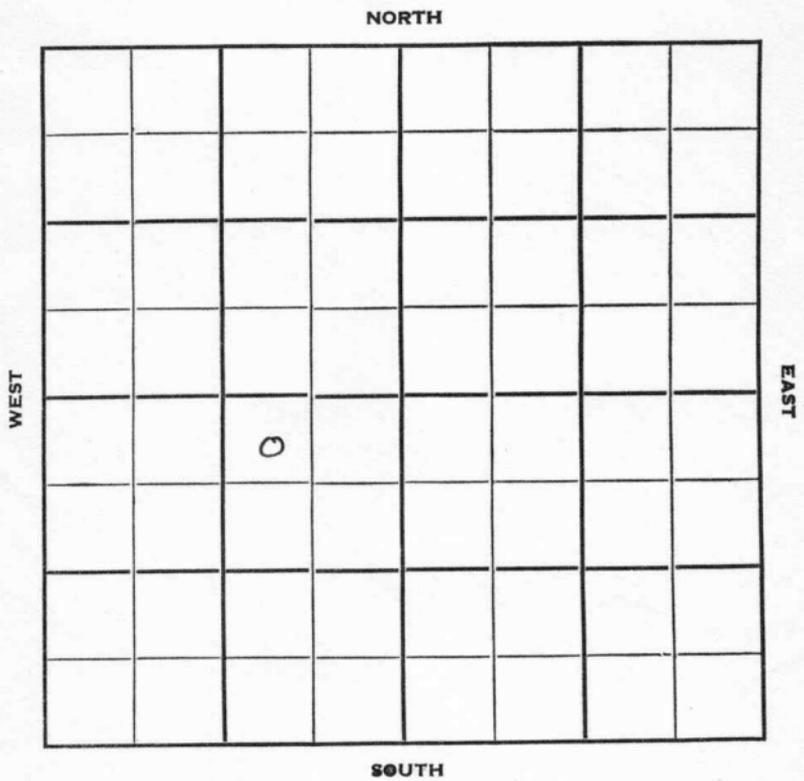

Sec. 27 Twp. 30 R. 15W

Well No. #1 Massey (D) Farm

Great Lakes Carbon Company

Patton Contractor

Massey


330 Ft. from N. Line

Ft. from S. Line

990 Ft. from E. Line

Ft. from W. Line

NW NE SW

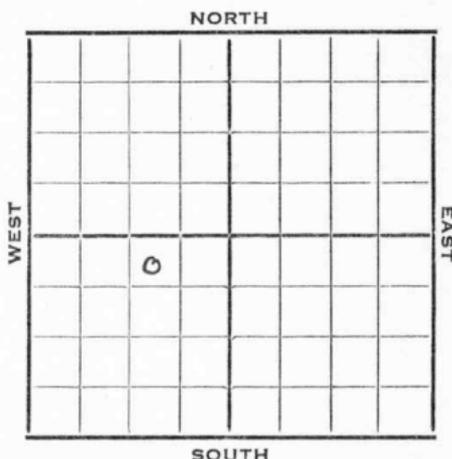

1952

Elev. 1737'

REPORT

- 4/2 RUR
- 4/9 12" @ 92' 8" @ 800'
Anhy 1575
Drlg. 2130'
- 4/23 Drlg. 3840'
- 4/30 Lans. 3859'
DST 4303-13' TD Failed
- 5/7 5" @ 4308 DP 4313 TD
Fill up 300' M CO
- 5/14 NR
- 5/21 Fill up 600' muddy oil DD 4319 TD
S/ 213 BO 12 hrs. 1 1/2% m
- 5/28 NR
- 6/11 Spud 4-1-52
Oil Well TD 4319'
12" @ 92' 8" @ 800'
Anhy 1575 Lans. 3859
DST 3403-13 failed 5" @ 4308'
TD 4313 FU 300' mud CO FU 600'
muddy oil DD 4319 S/ 213 bo
12 hr. Comp. F/ 75 bopd

COMPLETED


County Barber State Kansas

Sec. 27 (Blk. 30) (Sur. 15W) (Twp. 30) Map No.

Operator Great Lakes Carbon

Well No. 1 Farm Massey (D)

Elev. _____ Location NW NE SW

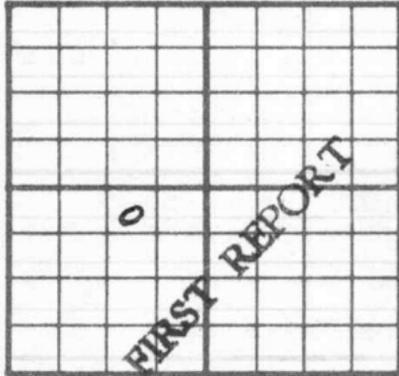

330 Ft. From N Line SW

990 Ft. From E Line Quarter

lst. Report APR 2 1952

Completion _____

Remarks _____

Patton - Contr.

Spudding Date _____

Drlg. Data Massey

RUR

J. G. McGEHEE

