


Section 27 Township 30 Range 15W

Well No. #3 Massey

Company Pryor & Lockhart

Sun City Pool NORTH

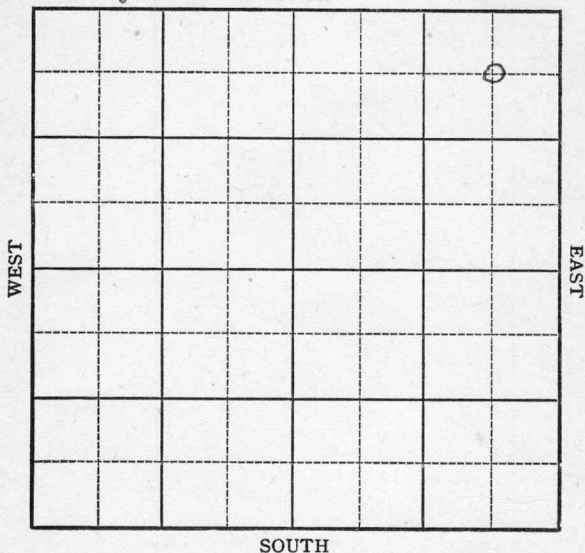

KANSAS

Barber

Sec. 27 Twp. 30 R. 15 W
Well No. #3, Massey Farm
Pryor & Lockhart Company

660

Ft. from N. Line


Ft. from S. Line

660

Ft. from E. Line

Ft. from W. Line

Elev. 1827

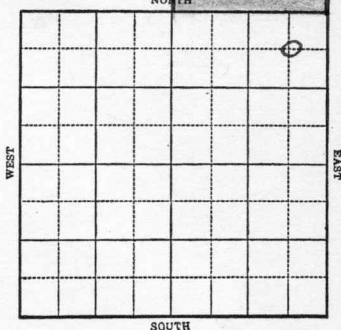

REPORT

1943
12/15 920 Run csg.
12/22 8" @ 894
WOC.
12/29 Drilling 2200' tools.
1944
1-5 Drilling 3200'
1/12 Drilling 4100'
1/19 Lans 3937
Stains 4391-98
5" @ 4440 TD
Rust
1/26 5" @ 4446 Corrected
Lans 3947
81 shots 4373-4414
4053 acid
TD 4446
Water

ABANDONED

Map No. 92 Sec. 27 Twp. 30 R. 15WWell No. 3 MasseyPryor & Lockhart

Company

FIRST REPORT

Contractor

C NE NE

SECTION PLAT

660 Ft. from N. Line

Ft. from S. Line

660 Ft. from E. Line

Ft. from W. Line

			o

Sun City Pool

Location _____

Rig up _____

Drilling and Remarks:

920 Run csg.

RECORD

Cased _____ in., _____ ft.

Sand _____

Gas _____

Oil _____

Total Depth _____

PRODUCTION

1st 24 hrs. Nat. _____

1st 24 hrs. after shot _____

Gas _____ Cu. Ft.

Dry Hole _____

Abandoned _____

Date

DEC 15 1943 19S. J. LEWIS Scout

Barbara

Map No. 92 Sec. 27 Twp. 30 R. 15WWell No. 3 MasseyPryor & Lockhart

Company

ABANDONED

Contractor

C NE NE

SECTION PLAT

			o

660 Ft. from N. Line

Ft. from S. Line

660 Ft. from E. Line

Ft. from W. Line

Sun City Pool

Location

Rig up

Drilling and Remarks:

*Loss 394?**5" @ 4446 Corrected**812 to 4372-4414**4053 Rec'd**11a Feb.*

RECORD

Cased _____ in., _____ ft.

Sand _____

Gas _____

Oil _____

Total Depth 4446

PRODUCTION

1st 24 hrs. Nat. _____

1st 24 hrs. after shot _____

Gas _____ Cu. Ft.

Dry Hole _____

Abandoned _____

Date

JAN 26 1944

19

S. J. LEWIS

Scout