


Section 27 Township 30 Range 15W

Well No. 4 Massey

Company NCRA

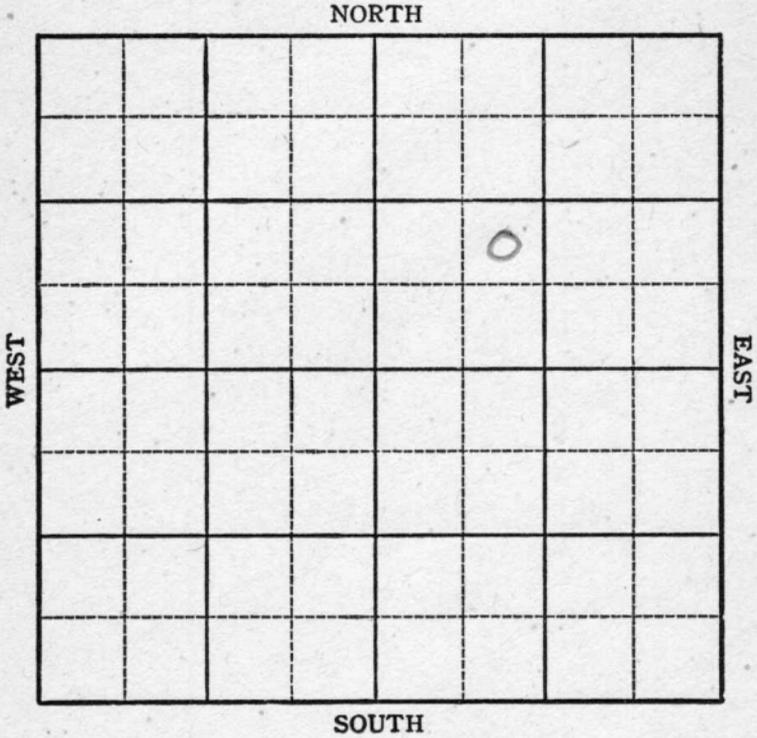

Sec. 27 Twp. 30 R. 15W

Well No. 4 Massey Farm

N C R A Company

Sun City.


Ft. from N. Line

990 Ft. from S. Line

Ft. from E. Line

990 Ft. from W. Line

NE SW NE

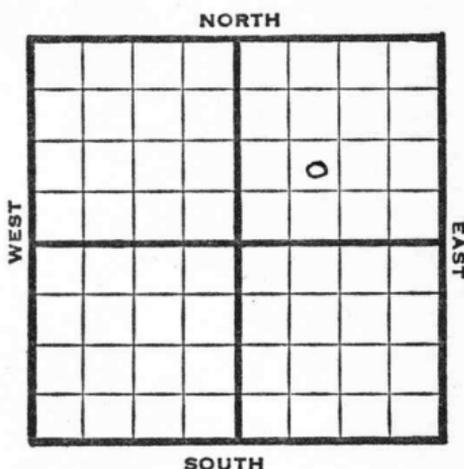

1947

Elev. 1829' REPORT

5/21

Location

5/27

Drlg. 760'

6/3

Drlg. 2991'

6/10

Drlg. 35200

6/17

Massey 4392'

TD 4411'

5" @ 4410 1/2'

RUST

6/24

" "

7/1

108 shots. 4383-4406'

4250' oil

7/8

6000 Acid

Flow 21 bbls. oil PH 10 hrs.

1/2 choke.

7/16

Massey 4392'

5" @ 4410 1/2'

Perf

6000 Acid

Bom & Pot 2965'

Gr. 39

T. D. 4411'

Complete

COMPLETED



