


Section 27 Township 30 Range 15W

Well No. #2 Massey B

Company Great Lakes Carbon

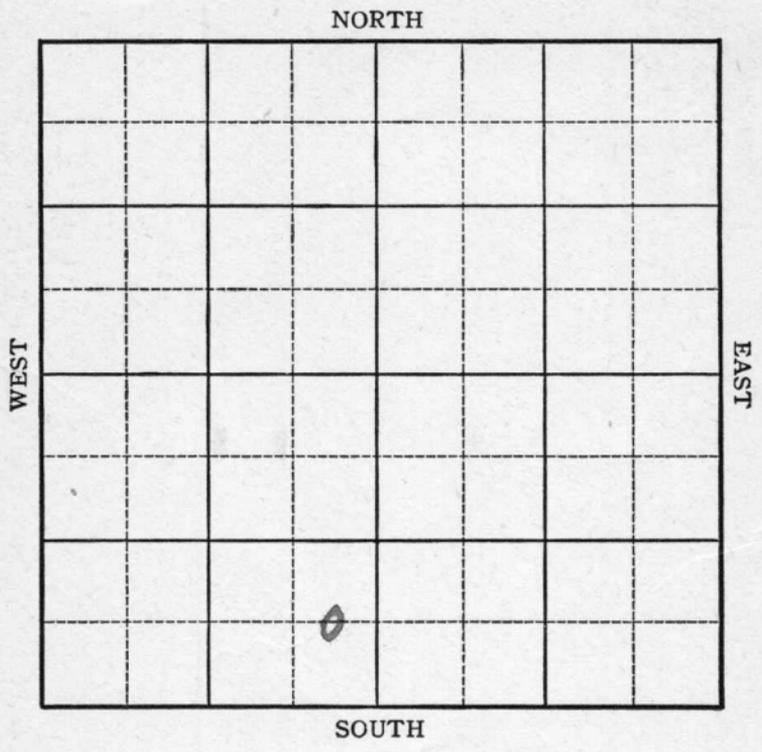

KANSAS

Sec. 27 Twp. 30 R. 15W

Well No. #2 Massey "B" Farm

Great Lakes Carbon Company

Sun City


_____ Ft. from N. Line

660 Ft. from S. Line

330
~~990~~ Ft. from E. Line

_____ Ft. from W. Line

CEL SE SW

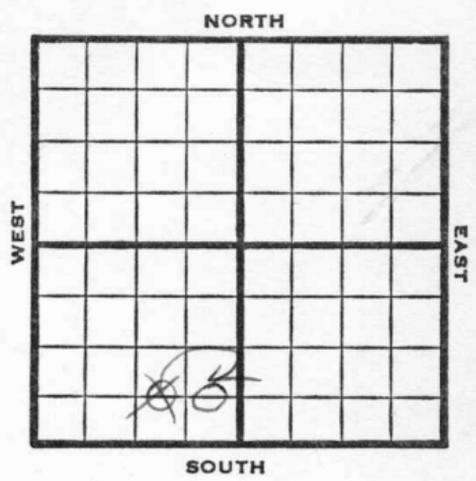

1946 Elev. 1736 REPORT

1/30 RUR
 2/7 8" - 743' Fsg. 1350'
 2/14 Drlg. 2995'
 2/21 Douglas 3737' Lans. 3852' 3841'
 Drlg. 4156'
 2/28 Lans. 3841' (Corrected)
 T.D. 4304' 5" - 4294' RUST.
 3/7 T.D. 4311' 1500 acid.
 Swab 31 oil per hour.

3/13 Lans 3841
 Magn. 4300
 5" @ 4294
 1500 acid.
 TD 4311'
 Bomb Pot. 3000
 Grav. 39.0

COMPLETED

KANSAS

Kansas Pool Name Sun City

Map No. 92 Sec. 27 Twp. 30 R. 15W

Well No. 2 Massey "B"

Great Lakes Carbon Company

CORRECTION

Contractor _____

C E L SE SW


_____ Ft. from N. Line

660 Ft. from S. Line

330 Ft. from E. Line

_____ Ft. from W. Line

SECTION PLAT

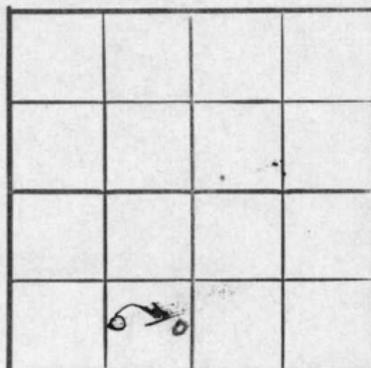

Barber County

Location _____

Rig up _____

Drilling and Remarks:

had it spotted
C W L SE SW

RECORD

Cased _____ in., _____ ft.

Sand _____

Gas _____

Oil _____

Total Depth _____

PRODUCTION

1st 24 hrs. Nat. _____

1st 24 hrs. after shot _____

Gas _____ Cu. Ft.

Dry Hole _____

Abandoned _____

Date

JAN 3 0 1946

19

S. J. LEWIS

Scout

KANSAS

Kansas

Pool Name Sun City

Map No. _____ Sec. 27 Twp. 30 R. 15W

Well No. 2 Massey "B"

Great Lakes Carbon Company

FIRST REPORT Contractor

C E L S E S W

SECTION PLAT

	o		

_____ Ft. from N. Line

660 Ft. from S. Line

990 Ft. from E. Line

_____ Ft. from W. Line

Correction

Barber County

SEE TICKET

Location _____

Rig up _____

Drilling and Remarks:
RUR

RECORD

Cased _____ in., _____ ft.

Sand _____

Gas _____

Oil _____

Total Depth _____

PRODUCTION

1st 24 hrs. Nat. _____

1st 24 hrs. after shot _____

Gas _____ Cu. Ft.

Dry Hole _____

Abandoned _____

Date

JAN 30 1946

19

S. J. LEWIS Scout

Kansas Pool Name Sun City

KANSAS

Map No. 92 Sec. 27 Twp. 30 R. 15W

Well No. 2 Massey "B"

Great Lakes Carbon Company

COMPLETED

Contractor

C E L S E S W

E 1/236
SECTION PLAT

 Ft. from N. Line

660 Ft. from S. Line

330 Ft. from E. Line

 Ft. from W. Line

Barber County

Location

Rig up

Drilling and Remarks:

Log 3841

Mag 4300

5' 04294

1500 acid

Bond BY 3000

39-2-4

RECORD

Cased in., ft.

Sand

Gas

Oil

Total Depth 4311

PRODUCTION

1st 24 hrs. Nat.

1st 24 hrs. after shot

Gas Cu. Ft.

Dry Hole

Abandoned

Date

MAR 13 1946 19

S. J. LEWIS Scout