


Section 27 Township 30 Range 15-W

Well No. #3, Massey "B"

Company Great Lakes Carbon

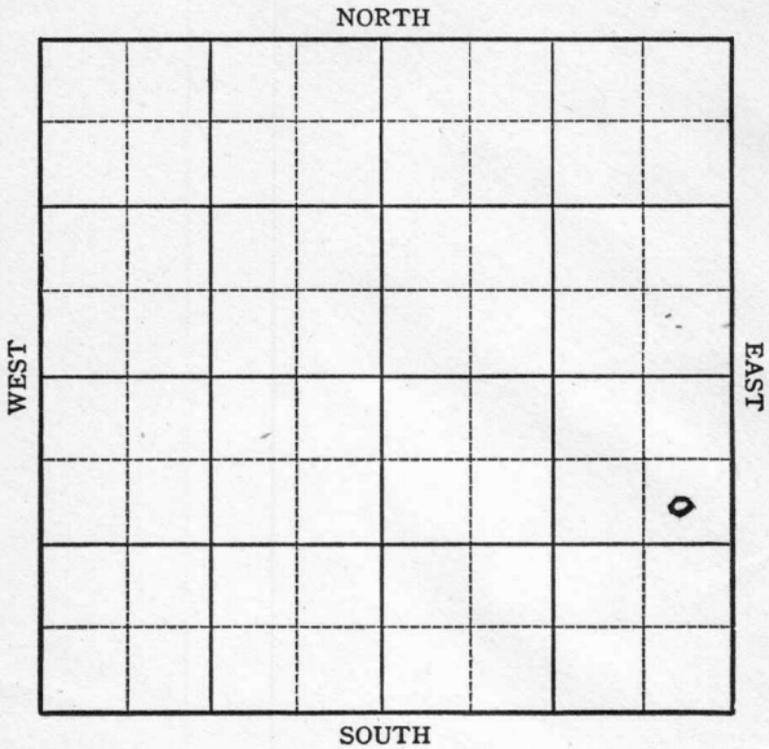

Sec. 27 Twp. 30 R. 15W

Well No. #3 Massey "B" Farm

Great Lakes Carbon Company


Sun City

990 Ft. from N. Line

Ft. from S. Line

330 Ft. from E. Line

Ft. from W. Line

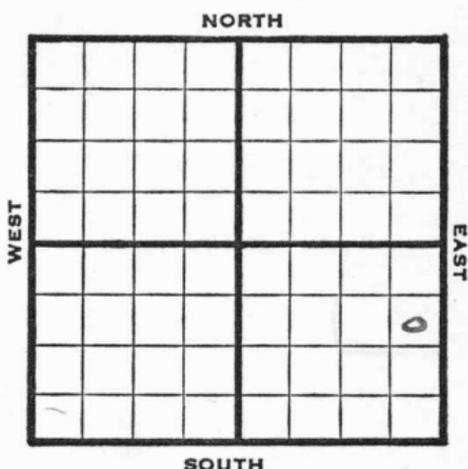

SE NE SE

1946

1780

REPORT

9/18	Anhy 612'		
	Drlg 1418'		
	8" @ 815'		
9/24	Drlg 2290'		
10/1	Drlg 3455'		
10/8	Massey 4344-45 TD		
	<del>XX</del> 5" @ 4334', RUST		
10/15	" "	"	"
10/22	" "	"	"
10/29	" "	"	"
11/6	" "	"	"
11/12	" "	"	"
11/20	" "	"	"
11/27	Massey 4344'		
	5" @ 4334'		
	TD 4351'		

ABANDONED

KANSAS

Kansas Pool Name Sun City

Map No. 92 Sec. 27 Twp. 30 R. 15W

Well No. 3 Massey "B"

Great Lakes Carbon Company

FIRST REPORT

Contractor

SE NE SE

SECTION PLAT

990 Ft. from N. Line  
 \_\_\_\_\_ Ft. from S. Line  
330 Ft. from E. Line  
 \_\_\_\_\_ Ft. from W. Line


Barber County

Location \_\_\_\_\_

Rig up \_\_\_\_\_

Drilling and Remarks:

Anhy 612'

8" @ 815'  
 1418'

RECORD

Cased \_\_\_\_\_ in., \_\_\_\_\_ ft.  
 Sand \_\_\_\_\_  
 Gas \_\_\_\_\_  
 Oil \_\_\_\_\_  
 Total Depth \_\_\_\_\_

PRODUCTION

1st 24 hrs. Nat. \_\_\_\_\_  
 1st 24 hrs. after shot \_\_\_\_\_  
 Gas \_\_\_\_\_ Cu. Ft.  
 Dry Hole \_\_\_\_\_  
 Abandoned \_\_\_\_\_

Date

SEP 1 8 1946 19

S. J. LEWIS Scout

Map No. 92 Sec. 27 Twp. 30 R. 15W

Well No. 3 Massey "B"

Great Lakes Carbon Company

**ABANDONED**

Contractor

SE NE SE

*E. 1, 1986*


**SECTION PLAT**

990 Ft. from N. Line

\_\_\_\_\_ Ft. from S. Line

330 Ft. from E. Line

\_\_\_\_\_ Ft. from W. Line

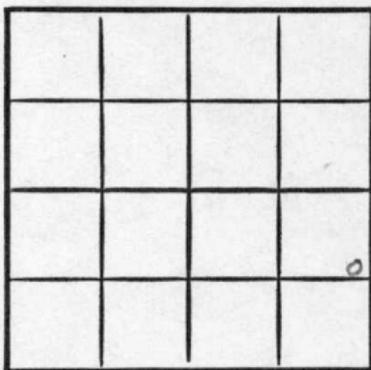

Barber County

Location \_\_\_\_\_

Rig up \_\_\_\_\_

Drilling and Remarks:

*Massey 4344*  
*5-11-4344*

**RECORD**

Cased \_\_\_\_\_ in., \_\_\_\_\_ ft.

Sand \_\_\_\_\_

Gas \_\_\_\_\_

Oil \_\_\_\_\_

Total Depth 4251

**PRODUCTION**

1st 24 hrs. Nat. \_\_\_\_\_

1st 24 hrs. after shot \_\_\_\_\_

Gas \_\_\_\_\_ Cu. Ft.

Dry Hole \_\_\_\_\_

Abandoned \_\_\_\_\_

Date

NOV 27 1946 19

S. J. LEWIS Scout