


Section 27 Township 30 Range 15W

Well No. #1 Massey "E"

Company Great Lakes Carbon

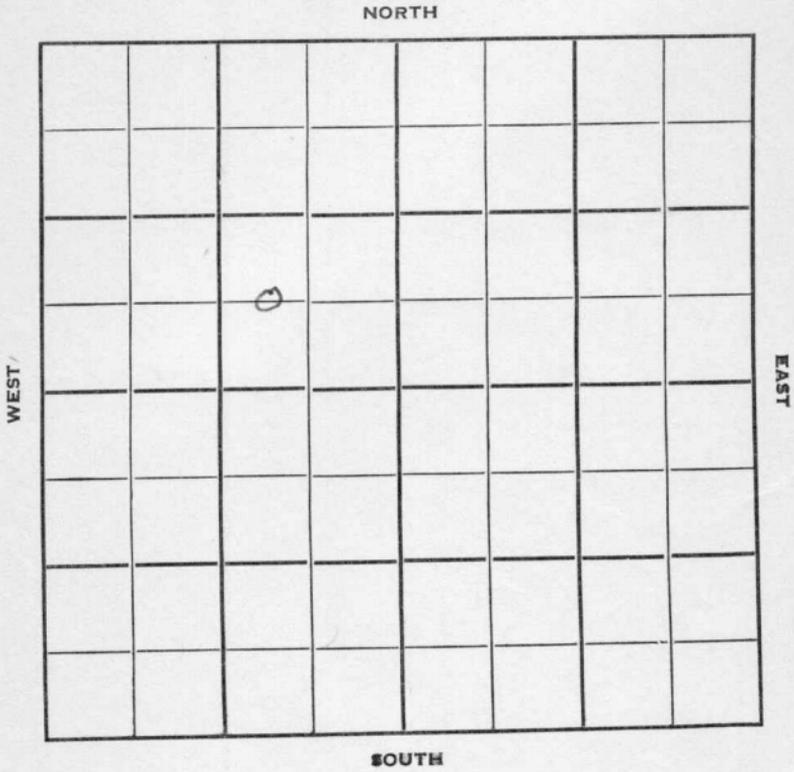

Sec. 27 Twp. 30 R. 15 W

Well No. # 1 Massey "E" Farm

Great Lakes Carbon Company

Patton Drlg. Contractor


Ft. from N. Line

660 Ft. from S. Line

990 Ft. from E. Line

Ft. from W. Line

C W L SE NW

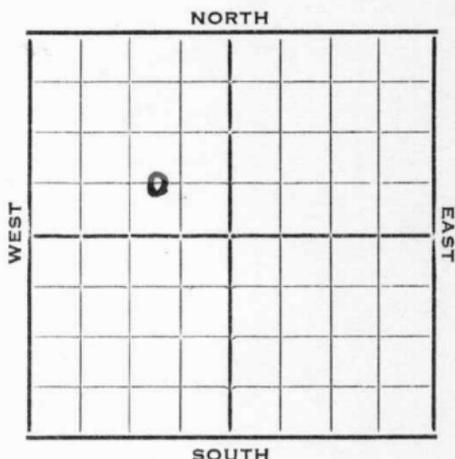

1952 Elev. 1757' REPORT

11/5 Spud 10-27-52  
Drlg. 2680'

11/12 8" @ 795 Drlg. 4030'

11/20 Anhy 1830' Massey zone 4333'  
DST 4309-49, 1½ hr, 15' M 100#  
RTD 4350'

11/27 NR

12/3 Spud 10-27-52  
D&A  
TD 4350'  
8" @ 795  
Anhy 1830, Massey zone 4333,  
DST 4309-49, opn 1½ hrs., rec.  
15' mud, 100#  
TD 4350  
D&A

**ABANDONED**


County Barber State Kansas

Sec. 27 (Blk. Twp.) 30 (Sur. Rge.) 15W Map No.

Operator Great Lakes Carbon

Well No. 1 Farm Massey "E"

Elev. \_\_\_\_\_ Location C W L SE NW

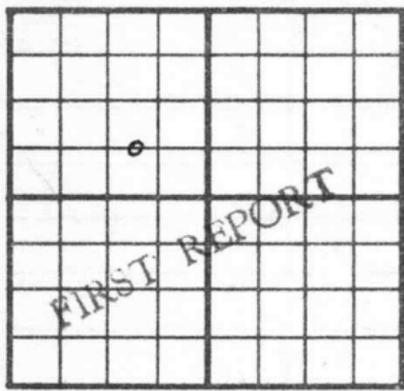

660 Ft. From S Line NW

990 Ft. From E Line Quarter

Ist. Report NOV 5 1952

Completion \_\_\_\_\_

Remarks \_\_\_\_\_

Patton Drlg. - Contr.

Spudding Date 10-27-52

Drlg. Data \_\_\_\_\_

drlg. 2680

J. G. McGEHEE


County Barber State Kansas

Sec. 27 (Blk. Twp.) 30 (Sur. Rge.) 15W Map No.

Operator Great Lakes Carbon

Well No. 1 Farm Massey "E"

Elev. 1757 Location C W L S E N W

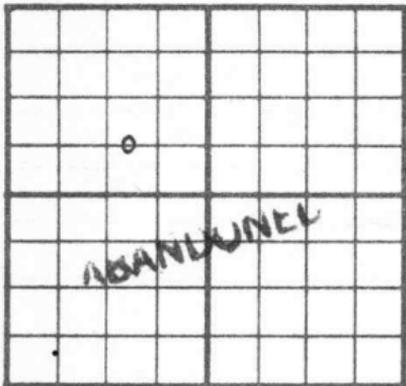

660 Ft. From S Line NW  
990 Ft. From E Line Quarter

1st. Report

Completion DEC 3 1952

Remarks

Patton Drlg. - Contr.

Spudding Date 10-27-52

Drlg. Data D & A TD 4350

8" @ 795 Anhy 1830 Massey zone 4333

DST 4309-49 open 1 1/2 hr. Rec. 15' mud

100# TD 4350

D & A