

Sec. 27 Twp. 30 Range 14W

#1 Pickens

Kansas Geological Society

J.A. Rowland et al

Skelly Scout Tickets

KANSAS

Map No.

Sec. 27

Twp. 30

R. 14 W

Well No. 1

Pickens

Farm

J. A. Rowland et al. Company

NORTH

WEST

EAST

SOUTH

Location _____

Drilling Remarks

Rig Up _____

Drilling Remarks

2835

RECORD

Cased _____ in. _____ ft.

Sand _____

Gas _____

Oil _____

Total Depth _____

PRODUCTION

1st 24 hrs. Nat. _____

1st 24 hrs. after shot _____

Gas _____ cu. ft.

Dry Hole _____

Abandoned _____

Map No. _____ Sec. 27 Twp. 30 R. 14 W

Well No. 1- Pickins Farm _____


J. A. Rowland et al Company _____

300 Ft. from N. Line

_____ Ft. from S. Line

990 Ft. from E. Line

_____ Ft. from W. Line

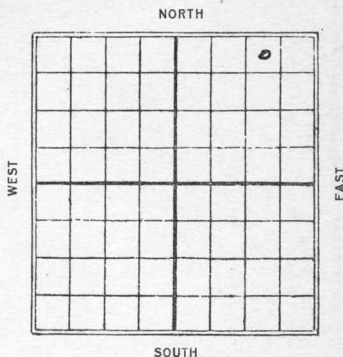

Date	REPORT
<u>4/25</u>	<u>T.D. 3330 - u.R. 6"</u>
<u>5/2</u>	<u>Drlg 3422 -</u>
<u>5/9</u>	<u>T.D. 3435 - u.R. 6"</u>
<u>5/16</u>	<u>Drlg 3450.</u>
<u>5/23</u>	<u>No report.</u>
<u>5/31</u>	<u>T.D. 3720 fishing bit -</u>
<u>6/6</u>	<u>—</u>
<u>6/13</u>	<u>—</u>
<u>6/20</u>	<u>T.D. 3720 fishing pipe -</u>
<u>6/27</u>	<u>—</u>
<u>7/3</u>	<u>—</u>
<u>7/11</u>	<u>—</u>
<u>7/18</u>	<u>—</u>
<u>7/25</u>	<u>—</u>
<u>8/1</u>	<u>—</u>
<u>8/7</u>	<u>—</u>
<u>8/15</u>	<u>S.D. 3720</u>
<u>8/22</u>	<u>TD 3720 C.O.</u>
<u>9/5</u>	<u>T.D. - 3821 u/R 6"</u>
<u>9/12</u>	<u>show oil @ 3846</u>
	<u>T.D. 3920 SD</u>
<u>9/19</u>	<u>—</u>

9/26 - show oil 3846'
S.D. 3920' T.D.

10/3

10/10 - T.D. 3920' VIR 6"

10/17

10/24 - Drly 4012'

10/31 - T.D. 4066 - VIR 6"

11/7 - Drly 4100'

11/14 - S.D. 4132 T.D. - S.L.M.

11/21

11/28

12/5

12/12 - Drly 4180'

12/19 - S.D. 4223'

12/26

1/29

1/2

1/9

1/16

1/23

1/30

2/6

2/13

2/20

2/27

3/6

3/13 - drly 4250'

3/20 - No report

3/27 - 5" - 4242' T.D. 4250'

4/3 - Drly 4290'

4/10 - show oil 4305'

Drly 4330'

4/17 - " 4512'

4/24 - VIR 5" - 4515' T.D.

5/1 - show oil 4544 - 4546

Drly 4615'

5/8 - show oil 4683 - HW 4685 - S.D.

5/15 - UR 5" - 4685

5/22 - UR 5" - 4691

5/29 - T.D. 4691 - E.O.

Barber

Map No. Kansas Sec. 27 Twp. 30 R. 14^W

Well No. 1 Pickens Farm


J. A. Rowland et al Company

300 Ft. from N. Line

_____ Ft. from S. Line

990 Ft. from E. Line

_____ Ft. from W. Line

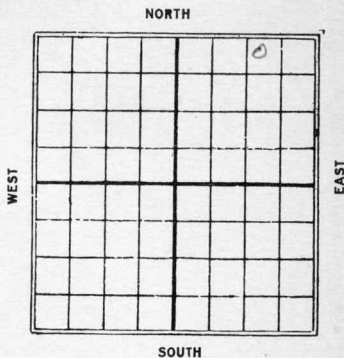

Date	REPORT
<u>1926</u>	
<u>5/5</u>	<u>Spud</u>
<u>5/12</u>	<u>Spud.</u>
<u>5/19</u>	<u>Spud. S.D.</u>
<u>5/26</u>	<u>" "</u>
<u>6/2</u>	<u>_____</u>
<u>6/9</u>	<u>_____</u>
<u>6/16</u>	<u>_____</u>
<u>6/23</u>	<u>_____</u>
<u>6/30</u>	<u>same</u>
<u>7/14</u>	<u>same</u>
<u>7/22</u>	<u>_____</u>
<u>8/4</u>	<u>same</u>
<u>8/11</u>	<u>_____</u>
<u>8/18</u>	<u>_____</u>
<u>8/25</u>	<u>_____</u>
<u>9/1</u>	<u>_____</u>
<u>9/8</u>	<u>T.D. 250-S.D.</u>
<u>9/12</u>	<u>_____</u>
<u>9/22</u>	<u>_____</u>
<u>9/29</u>	<u>_____</u>
<u>10/6</u>	<u>_____</u>
<u>10/20</u>	<u>_____</u>

10/13 - Same
 10/27 —
 11/3 —
 11/10 —
 11/17 —
 11/24 —
 12/1 - same

12/8 — 250 S.D.

12/15 —

12/21 —

12/29 —

1927

1/5 —

1/12 —

1/19 —

1/26 —

2/2 —

2/9 —

2/16 - Spud

1927- O.W.W.W.

8/24 - was aband. at 200'
 will be drilled
 on down

8/31 - Drlg 500-

9/7 - Shut down 500-

9/14 - T.D. 500 - S.D. for pipe-

9/20

9/28 - T.D. 500 - starting up-

10/5 - T.D. 500 - u.R. 15"

10/12 - Drlg 725

10/19 - " 965

10/26 - T.D. 1060 - u.R. 12"

11/2 - Drlg 1177'

11/9 - " 1811-

11/16 - " 2010-

11/22 - " 2125

11/29 - " 2450-8" @ 2450-

12/7 - T.D. 2505 - u.R. 8"

12/14 - T.D. 2600 - u.R. 8"

12/21 - no report -

12/18 - Drlg 2600-

1928

1/4 - " 2772

1/11 - T.D. 2806 - u.R. 8"

1/18 - Drlg 3085-

1/25 - S.D. 3195-

1/31

2/15

2/22

2/29

3/7

3/14

3/21

3/28 - T.D. 3195 - C.O.

4/4 - T.D. 3210-

drlg up u.R. logs

4/11 - T.D. 3306 - S.D.

4/18 - T.D. 3330 - u.R. 8"

D. & A.


Barber
 Map No. KANSAS Sec. 27 Twp. 30 R. 14^w
 Well No. 1- Pickens Farm
J.A. Rowland et al Company

330 Ft. from N. Line

_____ Ft. from S. Line

990 Ft. from E. Line

_____ Ft. from W. Line

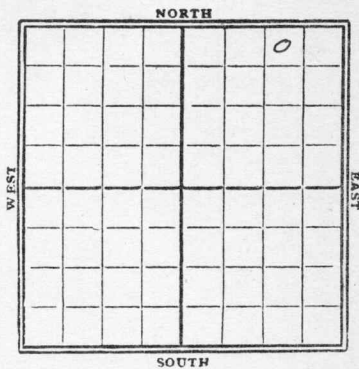

1929

Date

REPORT

6/5 Wilcox 4695 - 4718
T.D. 4718' - HFW
Dry & Abandon

Map No. KANSAS Sec. 27 Twp. 30 R. 14 W

Well No. 1 Pickens

J. A. Rowland & Co. Company

Contractor

SECTION PLAT

			0

330 Ft. from N. Line

..... Ft. from S. Line

990 Ft. from E. Line

..... Ft. from W. Line

ABANDONED

Location.....

Rig up.....

Drilling and Remarks:

Wilcox Sand

4695-4718

N H W

D H

RECORD

Cased..... in., ft.

Sand.....

Gas.....

Oil.....

Total Depth 4718

PRODUCTION

1st 24 hrs. Nat.....

1st 24 hrs. after shot.....

Gas..... Cu. Ft.

Dry Hole.....

Abandoned.....

Date

JUN 5 1929

192.....

S. J. LEWIS

Scout

no wall
no wall

Returned.....	<i>Lib</i>
Cards.....	<i>CPK</i>
Tracing.....	<i>CPK</i>
France Map.....	<i>CPK</i>
Scarborough Map.....	<i>CPK</i>
Moody Map.....	<i>CPK</i>
Scarborough Plat Book.....	<i>CPK</i>
Moody Plat Book.....	<i>CPK</i>

Map No. KANSAS Sec. 27 Twp. 30 R. 14W

Well No. 1 Pickens

J. C. Rowland & Co. Company

Contractor

SECTION PLAT

300 Ft. from N. Line

_____ Ft. from S. Line

990 Ft. from E. Line

_____ Ft. from W. Line

			0

ABANDONED

RECORD

Location _____

Cased _____ in., _____ ft.

Rig up _____

Sand _____

Drilling and Remarks:

Gas _____

Oil _____

Total Depth _____

PRODUCTION

1st 24 hrs. Nat. _____

1st 24 hrs. after shot _____

Gas _____ Cu. Ft.

Dry Hole _____

Abandoned _____

Date

FEB 16 1927

S. J. LEWIS

Scout

No
Wall
Map

Returned	
Labels	<i>mm</i>
Tracing	<i>None</i>
France Map	
Scarborough Map	<i>X</i>
Moody Map	
Scarborough Plat Book	
Moody Plat Book	

Map No. *h w map* **KANSAS** Sec. *27* Twp. *30* R. *14 N*

Well No. *1 Pickens*

J. A. Rowland & Co. Company

Contractor

SECTION PLAT

			0

300 Ft. from N. Line

----- Ft. from S. Line

990 Ft. from E. Line

----- Ft. from W. Line

FIRST REPORTS

Location -----

Rig up -----

Drilling and Remarks:

Spud.

RECORD

Cased ----- in., ----- ft.

Sand -----

Gas -----

Oil -----

Total Depth -----

PRODUCTION

1st 24 hrs. Nat. -----

1st 24 hrs. after shot -----

Gas ----- Cu. Ft.

Dry Hole -----

Abandoned -----

Date

MAY 5 - 1926 *192*

S. J. LEWIS

Scout

Well No. _____
 Company _____
 Contractor _____

SECTION PLAT

_____ ft. from N. line
 _____ ft. from S. line
 _____ ft. from E. line
 _____ ft. from W. line

RECORD

Cased in _____ ft.
 Sand _____
 Gas _____

Location _____
 Bit up _____
 Drilling and Remarks _____

Returned	
Cards	
Tracing	
France Map	
Scarborough Map	X
Moody Map	
Scarborough Plat Book	
Moody Plat Book	

no maps

Date _____

Map No. KANSAS Sec. 27 Twp. 30 R. 14W

Well No. 1 Pickens

J. A. Rowland & Co. Company

Contractor

SECTION PLAT

300 Ft. from N. Line

_____ Ft. from S. Line

990 Ft. from E. Line

_____ Ft. from W. Line

			0

Location _____

Rig up _____

Drilling and Remarks:

*This was a hand bored
on 2/16/27 at 250
ft.*

*Has been sacked
by Derby, Grey.
and O'Brien and is
going to drill it.*

Date

RECORD

Cased _____ in., _____ ft.

Sand _____

Gas _____

Oil _____

Total Depth _____

PRODUCTION

1st 24 hrs. Nat. _____

1st 24 hrs. after shot _____

Gas _____ Cu. Ft.

Dry Hole _____

Abandoned _____

AUG 24 1927

192

S. J. LEWIS

Scout

new wall
new