

O.W.W.O.

DX 78-1

Barber


KANSAS

Section 27 Township 30 Range 11 W

Well No. # 1 Mease

Company Aylward Drlg. et al

NORTH

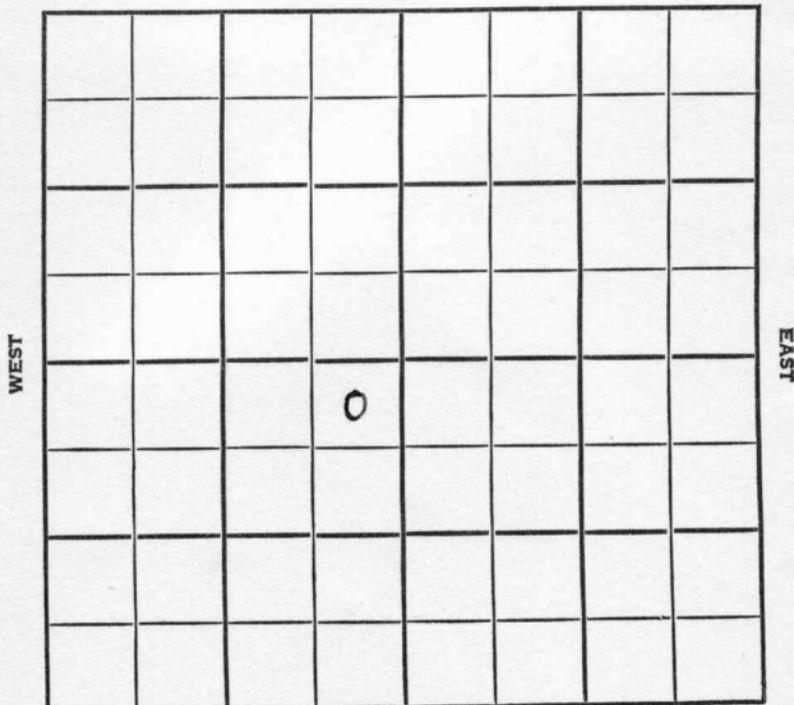

SOUTH

O.W.W.O.

Barber KANSAS


|            |            |           |
|------------|------------|-----------|
| SEC.<br>27 | TWP.<br>30 | R.<br>11W |
|------------|------------|-----------|

WELL NO. 1 Mease FARM

COMPANY Aylward Drlg. et al

CONTRACTOR Co. Tools Wildcat

330 Ft. from N. Line  
 \_\_\_\_\_ Ft. from S. Line  
 330 Ft. from E. Line  
 \_\_\_\_\_ Ft. from W. Line

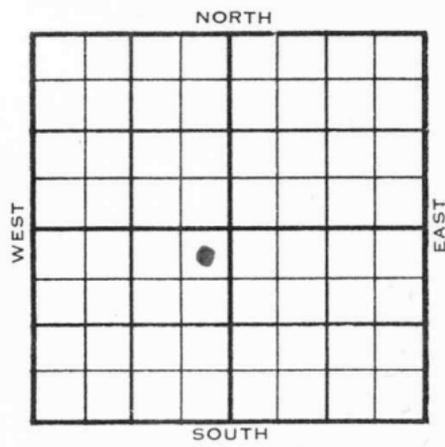

NE NE SW  
 SDX-1/2 Mile

|      | ELEVATION | REPORT |
|------|-----------|--------|
| 1954 | 1781'     |        |

9/29 MIRT  
 11/3 Spud 9-25-54 - Gas Well  
 TD 3769'  
 8-5/8" @ 130'  
 Doug. 3759'  
 DST 3759-69', opn 1 hr., 7,000,000  
 CFG, 1295#  
 TD 3769'  
 5" @ 3759'  
 Comp. SI Gas Well  
 5,000,000 cfspd

**COMPLETED**

1957  
 1/16 O.W.W.O.  
 OTD 3769' - Comp. in 1954 in Doug.  
 To whipstock & go for Miss.

County Barber State Kansas

Sec. 27 (Blk. 30) (Sur. 11W) (Twp. 30) Map No.

Operator Aylward Drlg. etal.

Well No. 1 Farm Mease

Elev. 1781 Location NE NE SW

|          |  |  |  |  |  |  |  |  |  |
|----------|--|--|--|--|--|--|--|--|--|
| COMPLETE |  |  |  |  |  |  |  |  |  |
|          |  |  |  |  |  |  |  |  |  |
|          |  |  |  |  |  |  |  |  |  |
330 Ft. From N Line SW

330 Ft. From E Line Quarter

1st. Report

Completion NOV 3 1954

Remarks Wildcat

Co. tools

Spudding Date 9-25-54

Drlg. Data Gas well TD 3769

8 5/8" @ 130 Doug. 3759 DST 3759-69

open 1 hr. 7,000,000 cfg 1295#

TD 2769 5" @ 3759

Comp. SI gas well 5,000,000 cfgpd

NOV 10 1954

|                |    |
|----------------|----|
| Scout Cards    | 42 |
| Land Small Map |    |
| Land Wall Map  | 33 |
| Tracings       |    |
| France Map     |    |
| Pierce Map     |    |
| Misc.          |    |

County **Barber** State **Kansas**

Sec. **27** (Blk.) **30** (Sur.) **11W** Map No.

Operator **Aylward Drlg., etal**

Well No. **1** Farm **Mease**

Elev. Location **NE NE SW**

|              |  |  |  |  |  |  |  |  |  |
|--------------|--|--|--|--|--|--|--|--|--|
| FIRST REPORT |  |  |  |  |  |  |  |  |  |
|              |  |  |  |  |  |  |  |  |  |
|              |  |  |  |  |  |  |  |  |  |
**330** Ft. From **N** Line **SW**

**330** Ft. From **E** Line Quarter

1st. Report **SEP 29 1954**

Completion

Remarks

**Co. Tools**

Spudding Date

Drlg. Data **Wildcat**

**MIRT**

FABEN GILSTRAP

OCT

1 1954

|                |    |
|----------------|----|
| Scout Cards    | 60 |
| Land Small Map |    |
| Land Wall Map  | 57 |
| Tracings       |    |
| France Map     |    |
| Pierce Map     |    |
| Misc.          |    |

Orig. Data



County Barber Elev. 1781  
 Sec. 27 Twp. 30 Rge. 11W  
 Company Arford Inc.  
 Lease Case No. 1

|                 | DEPTH | LOG             | DATUM | Loc. in Sec.          |
|-----------------|-------|-----------------|-------|-----------------------|
| H.              |       |                 |       | NE NE SW              |
| Tr.             |       |                 |       | OWNO                  |
| Dg.             | 3750  |                 |       |                       |
| BL.             |       |                 |       |                       |
| L.              | 3868  |                 |       | Geol.                 |
| K.C.            |       |                 |       | Contr.                |
| B.K.C.          |       |                 |       | Co. tools             |
| Ce.             |       |                 |       |                       |
| C.              |       |                 |       | Pool                  |
| M. <u>chert</u> | 4429  |                 |       |                       |
| M.              |       |                 |       |                       |
| K.              |       |                 |       |                       |
| Mz.             |       |                 |       |                       |
| Ma.             |       |                 |       |                       |
| V.              |       |                 |       |                       |
| S.              |       |                 |       |                       |
| S.              |       |                 |       |                       |
| A.              |       |                 |       |                       |
| R.              |       |                 |       |                       |
| Pe.             |       |                 |       |                       |
| G.              |       |                 |       |                       |
| T.D.            | 4470  | <del>4470</del> |       | ABANDONED<br>1/2 mile |

Date Comm. \_\_\_\_\_  
 Comp. in 1954 in Doug, to whipstock  
 and go for Miss. JAN 29 57 3030  
 (Whipstock set @ 2000) JAN 30 57  
~~DST 4429~~ FEB 6 57 DST 4396  
 -4410 1hr rec 21' VSGCM  
 BHP 25 DST 4430-70 ops  
 1hr rec 25' oil spnd Md BHP  
 45/20"  
 D&A