
Kingman KANSAS

DX 78-1

Section 27 Township 30 Range 8W

Well No. 1 Joe Tjaden "B"

Company ~~Stanolind~~

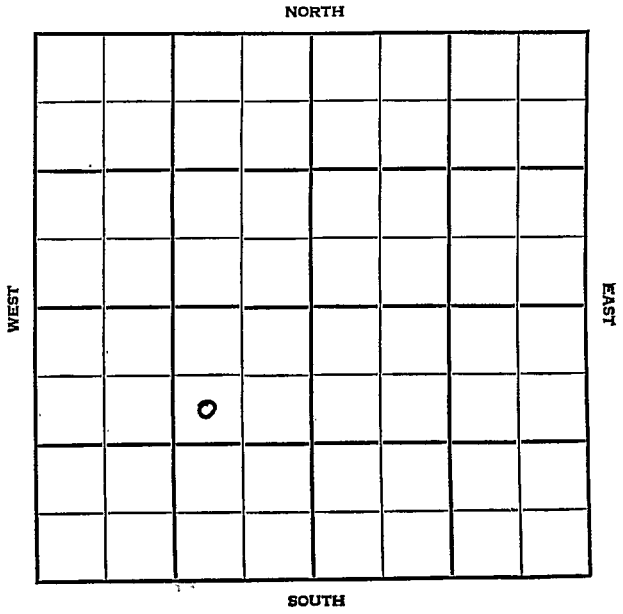

Kingman KANSAS

| SEC. | TWP. | R. |
|---|---|---|
| 27 | 30 | 8W |

WELL NO.

1 Joe Tjaden "B" FARM

COMPANY

Stanolind

CONTRACTOR

Prime Drlg.

Spivey Pool


990 Ft from N. Line

Ft. from S. Line

990 Ft. from E. Line

Ft. from W. Line

SW NE SW

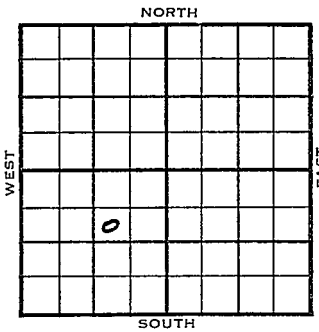


| 1954 | ELEVATION 1645' REPORT |
|---|---|
| 6/15 | MIR |
| 6/23 | 8" @ 223 w/250<br>Drlg. 3287' |
| 6/30 | Lans 3547<br>Ø 4348 |
| 7/7 | Miss 4332<br>DST 4335-90 1 Hr. 4, 070,000 gas<br>90 g & OCW 90' wtr 1470#<br>DST 4390-4442 1 hr. 180' gcm 460'<br>Hlg & SOCM 260' wtr 1620#<br>Drlg. 4475 |
| 7/21 | Spud 6-13-54 - Oil Well<br>TD 4475'<br>8" @ 223'<br>Lans 3547', Miss 4332'<br>DST 4335-90', opn 1 hr., 4,070,000<br>CFG, 90' gas & ocw, 90' wtr, 1470#<br>DST 4390-4442', opn 1 hr., rec. 180'<br>gcm, 460' HG&SOCM, 260' wtr, 1620#<br>TD 4475'<br>5½" @ 4475'<br>CO to 4443', 60/4399-4414, S/4 boph<br>10% wtr., sd-oil-frac, 20 bfph 30% wtr<br>Comp. 50 bopd 50% wtr. |

COMPLETED

DX-78

FORM 275 FOR SALE BY KANSAS BLUE PRINT CO.


County Kingman State Kansas

Sec. 27 (Blk. Twp.) 30 (Sur. Rge.) 8W Map No.

Operator Stanolind

Well No. 1 Farm Joe Tjaden "B"

Elev. Location SW NE SW

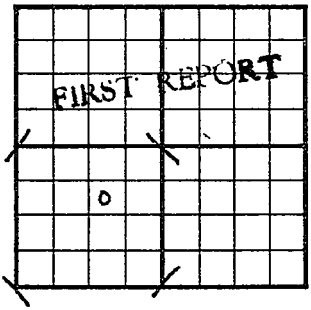


990 Ft. From N Line SW

990 Ft. From E Line Quarter

1st. Report JUN 15 1954

Completion

Remarks Prime Drlg. - Contr.

Spudding Date

Drlg. Data Spivey Pool

N I R

J. G. McGEHEE

FORM 275 FOR SALE BY KANSAS BLUE PRINT CO.


County Kingman State Kansas

Sec. 27 (Blk. Twp.) 30 (Suf. Rge.) 8W Map No.

Operator Stanolind

Well No. 1 Farm Joe Tjaden "B"

Elev. 1645 Location SW NE SW

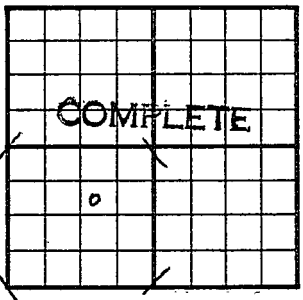


990 Ft. From N Line SW

990 Ft. From E Line Quarter

1st. Report

Completion JUL 21 1954

Remarks Spivey Pool

Prime Drlg. - Contr.

Spudding Date 6-13-54

Drlg. Data Oil well TD 4475

8" @ 223 Lans. 3547 Miss. 4332

DST 4335-90 open 1 hr. 4,070,000 cfg

90' gas & ocw 90' wtr. 1470#

DST 4390-4442 open 1 hr. Rec. 180' gcm

460' hg & s ocm 260' wtr. 1620#

TD 4475 5½" @ 4475 CO to 4443

60/ 4399-4414 S/ 4 boph 10% wtr.

sd-oil-frac 20 bfph 30% wtr.

Comp. 50 bopd 50% wtr.

J. G. McGEHEE