


SECTION 27 TOWNSHIP 30 RANGE 6W

WELL NO. #1 ~~Grifford~~ Crane

COMPANY Sierra & Leonard Isern

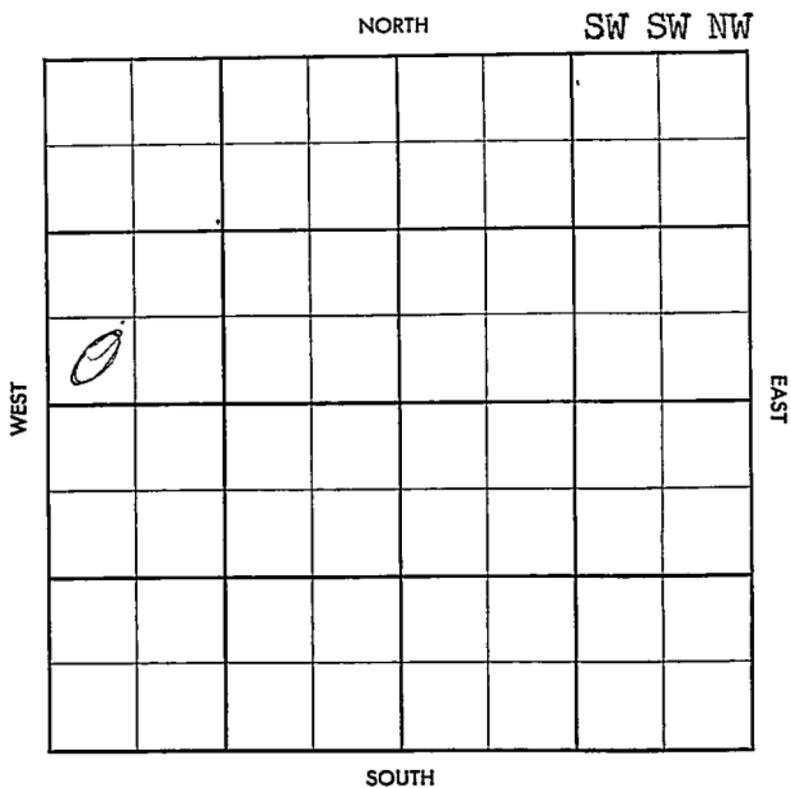

WILDCAT

FORM 513 SUNRAY

County Kingman Elev. _____
 Sec. 27 Twp. 30 Rgs. 6W
 Company Sierra & Leonard Isern
 FarmName Crawford No. 1

TOPS	DEPTH	LOG	DATUM
Anh.			
Tp.			
H.			
Tr.			
Dg.			
Bl.			
L.			
K.C.			
B.K.C.			
Ce.			
C.			
M.			
M.			
K.			
Mz.			
Mo.			
V.			
S.			
S.			
A.			
R.			
PE.			
G.			
TD.			

Loc. in Sec. SW SW NW
 Geol. _____
 Contr. _____
 Co. Tools _____
 Pool Wildcat
FIRST REPORT
 MAY 29 '57

Date Comm. _____
 Location _____

~~27~~

Co. No. Sec. T. R.

CORRECTION

FORM 519 SUNRAY

Co.

Lse.

No.

Sec.

T.

R.

County Kimman Elev. 1425
 Sec. 27 Twp. 30 Rge. 6
 Company Sierra & Leonard Lsarn
 Farm Name Clawford crane No. 1

TOPS	DEPTH	LOG	DATUM
Anh.			
TP.			
H.			
Tr.			
Dg. <u>sd</u>	<u>3372</u>		
Bl.			
L.	<u>3550</u>		
K.C.			
B.K.C.			
Ce.			
C.			
M.	<u>4122</u>		
M.			
K.	<u>4402</u>		
Mz.			
Ma.			
V.			
S. <u>0610</u>	<u>4585</u>		
S.			
A.	<u>4650</u>		
R.			
PE.			
G.			
T.D.	<u>4675</u>		

Loc. in Sec. SW NW

Geol. _____
 Contr. _____
 Co. Tools _____

Pool Wildcat

ABANDONED
 JUN 26 '57

Date Comm. 3 Kelly D.H.M.
 Location W 5 '57 " " '57 6-4-57 MTR

858 256/140 10 3774 JUN 14 '57
DST 4126-40 or 90" G/12"
TSTM rec 45' H5CM BHP
1600/30" DST 4140-55 or
90" G/7" ga 44 MFCU rec
105' 50 E H6CM FPO BHP
1445/30" DST 4168-92 or
90" rec 125' 50 E 6CMW

BHP 1280/30 104468 19.2° 57

DEW