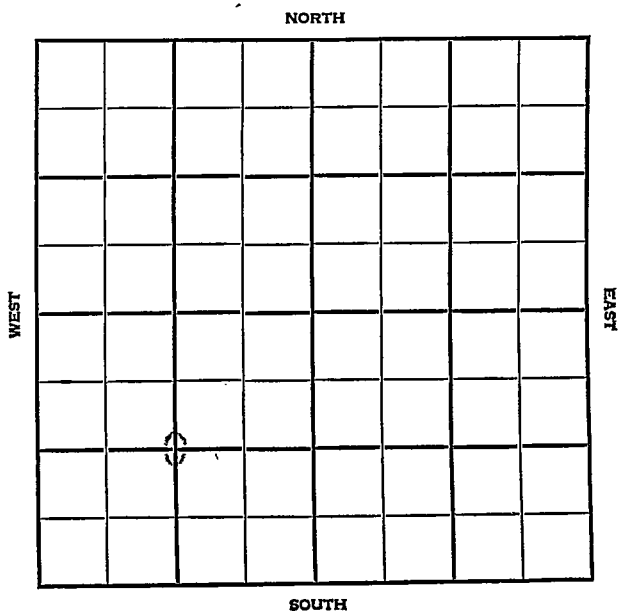


Section 27 Township 30 Range 42WWell No. 1 UdstadCompany Superior

Stanton

KANSAS

SEC.	TWP.	R.
27	30	42 W

WELL NO.

1 Udstad

FARM

COMPANY

Superior Oil

CONTRACTOR


Sparks

Ft. from N. Line

Ft. from S. Line

Ft. from E. Line

Ft. from W. Line

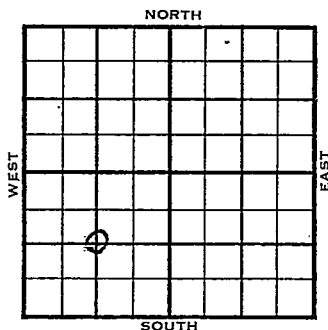

C SW/4

3/4 Mile - SD-X

	ELEVATION	REPORT
1955	3525'	5400' Miss. Test
7/13	Spud 7-4-55 10" @1518/800 Drlg. 2863'	
7/22	Drlg. 4303	
7/28	Morrow zone 5232, DST 5300-20, open 1 hour, rec 10' mud 0# drlg 5340	
8/3	Miss. Test. DST 5300-20 open 1 hr. rec. 20' mud, all press. 0# DST 5320-40 open 1 rh. rec. 300' msw, FP 107# to 225# log; D&A	
	L. Morr 5232	5232 1707
	TD 5391	

ABANDONED

County Stanton Elev. _____
 Sec. 27 Twp. 30 Rge. 42W
 Company Superior Oil
 Farm Name Udstad No. 1

TOPS	DEPTH	LOG	DATUM	Loc. in Sec.
Anh.				<u>C SW/4</u>
Tp.				
H.				
Tr.				
Dg.				Geol. _____
Bl.				Contr. _____
L.				Pool _____
K.C.				<u>Sparks</u>
B.K.C.				
Ce.				<u>3/4 mile</u> FIRST REPORT <u>JUL 12 '55</u>
C.				
M.				
M.				
K.				
Mz.				
Me.				
V.				
S.				
S.				
A.				
R.				
Pe.				
G.				
T.D.				

Date Comm. 7-4-55 5400' Miss test
 10" @ 1518/800 drlg. 2863

24

County Stanton Elev. 3525Sec. 27 Twp. 30S Rge. 42W.Company Superior OilFarmName Udstad No. 1

TOPS

DEPTH

LOG

DATUM

Loc. in Sec.

Anb.

Tp.

H.

Tr.

Dg.

Bl.

L. Morr. 2v

K.C.

B.K.C.

Ce.

C.

M.

M.

K.

Mz.

Ma.

V.

S.

S.

A.

R.

P.E.

G.

T.D.


523252321707

Geol.

Contr.

Pool

Sparks

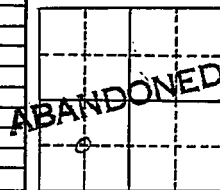Date Comm. 7-4-55; 5400' Miss. test AUG -3 1955

10" @ 1518 w/800; DST 5300-20 open 1 hr.
rec. 20' mud, all press. 0#; DST 5320-40 open
1 hr. rec. 300' msw, FP 107# to 225#;

log: D & A