


Kiowa

KANSAS

SECTION 28 TOWNSHIP 30S RANGE 16W

WELL NO. #1-28 Robbins Unit

COMPANY Shell

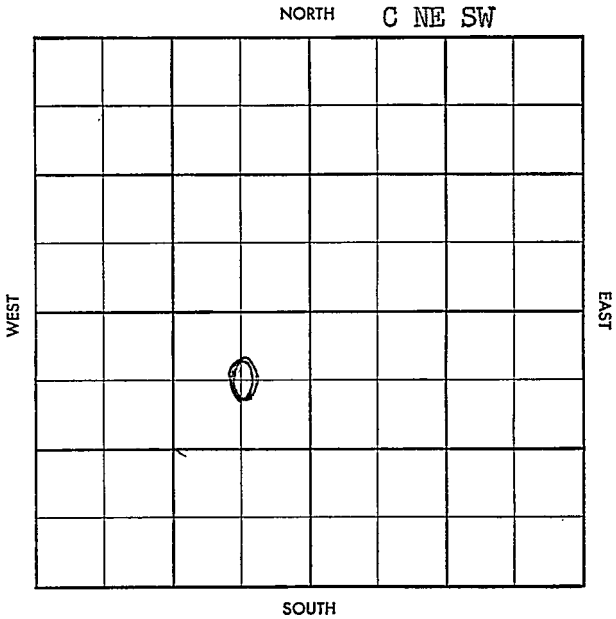

CO. ~~Kiowa~~ ELEV. _____
 SEC. ~~28~~ TWP. ~~30~~ RGE. ~~16W~~
 COMPANY ~~Shell~~ NO. ~~1-28~~

FIRST REPORT	
o	
JV 27 57	

FARM Robbins Unit

LOC. C NE SW

GEOL. _____

CONTR. Lewis Drlg.

POOL Glick

SPUD 11/23/57

8" @ 509 w/500, w/spd
MIRT

CO.

LSE.

NO.

SEC.

TWP.

RGE.

S-513-A

CO. KiowaELEV. 1893.0SEC. 28TWP. 30RGE. 16W

COMPLETE

COMPANY ShellNO. 1-28

DEC 26 '57

FARM Robbins UnitLOC. C NE SW

GEOL. _____

CONTR. Lewis Drilg.POOL ClickSPUD 11/23/578" 509 w/500, w/spd11/27 DEC 4 '57 Hb.3924 LKC 4/11Ø 440) PER 100'M 4695 TD4875 run log5" 4860/150 Log topsHb 3923 LKC 4/11 Mal4543 M 4693 K 4850DEC 18 '57 CO 4822 96/4726-50500 A. 5110 h-s SICP 1520F10 2.600 mcf + Ld 3 1/2 hrsCP 500 frac 16 x 15 5112Hrs (1/2) SF DEC 17 ODF 1030.000 mcf 51P 1534M 4726-50 TD 4875

CO.

LSE.

NO.

SEC.

TWP.

RGE.