

KANSAS


FORM 51 5M BR1X

Barber County

Section 28 Township 30 Range 13W

Well No. #1 Clay

Company Huber Oil

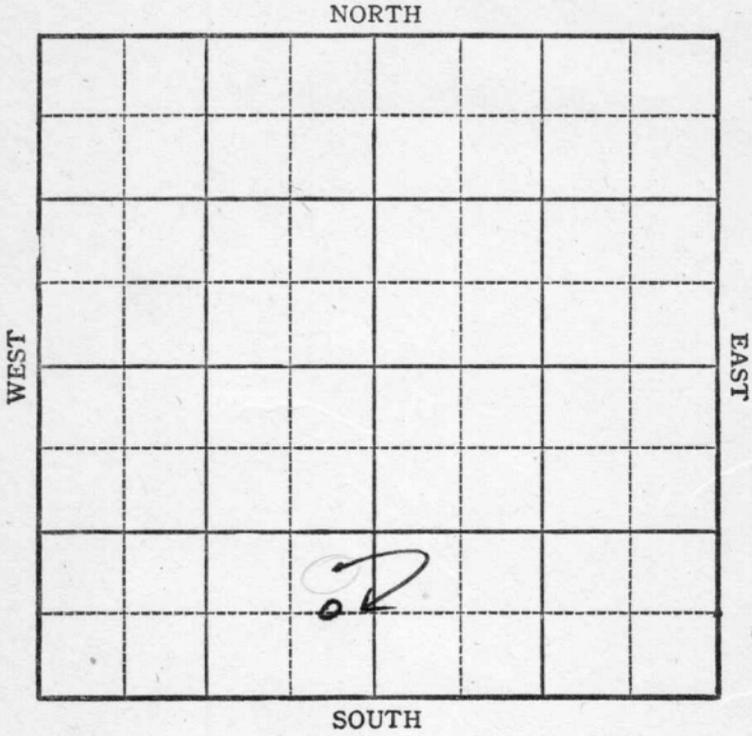

Sec. 28 Twp. 30 R. 13W


Well No. #1 Clay Farm _____
Huber Oil Company _____

_____ Ft. from N. Line

990 Ft. from S. Line

330 Ft. from E. Line

_____ Ft. from W. Line

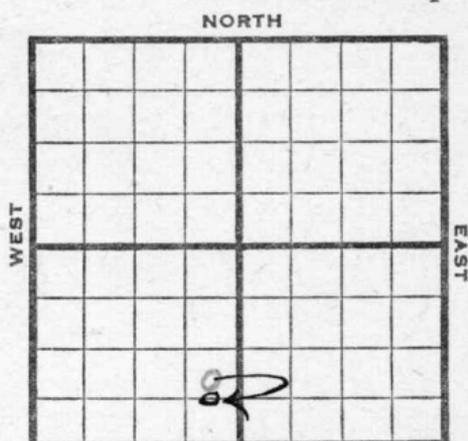

NE SE SW Elev. 1886

1945

R E P O R T

1/17 Location

1/26 RUB

1/31 "

2/7 "

2/14 10" @ 801
Drlg 2135

2/21 Drlg 3790

2/28 Topeka 3110
Heebner 3789
Douglas 3861
Lans 3967
Miss Chert 4418
Drlg 4438 SSO

3/7 Viola 4608
Simp Sd 4717 -30 TD
5" @ 4675 RUST

3/14 24 shots 4602-10
750 acid 10 M gas
spray oil

3/23 PB 4623 12 shots 4610-4612
250 acid 3 fluid per hr.
10% oil 750 acid.

3/29 PB #613
24 shots 4607-4609
12 shots 4605-4607 250 acid.
Trace oil 1000 acid

4/5 " " " " " " OVER

1945

4-14 Plugged Back to 4593'
Perforated 12 holes 4589-93'
Swab 6 bbls. fluid per hour.
Perforated 70 holes 4583-89'
Acidized with 1000 gallons.
Flowed 164 bbls. oil in 10 hours.
No water.
 $1\frac{1}{2}$ Million gas. (Tel)

4/12 PB 4813 " " " "

4/20 5000 acid.
Flow 164 oil 10 hrs.

4/27 " " " " "

5/3 " " " " "

5/10 " " " " "

5/17 " " " " "

5/23 Lans 3967

Miss 4418

Simp Sd 4717

5" @ 4675

TD 4730

20 shots 4583-4589

5750 acid.

Flow 240 Pot.

Grav. 40.0

COMPLETED

Misc. Small Maps *LR*
 Cards *LR*
 Tracing _____
 France Map _____
 Scarborough Map _____
 Moody Map _____
 Geological Dept. _____
 Moody Plat Book _____

LR

Pool Name No name

Map No. K92 Sec. 28 Twp. 30 R.13W

Well No. 1 Clay

Huber Oil Company

CORRECTION Contractor

C E L S E SW

SECTION PLAT

 Ft. from N. Line

660 Ft. from S. Line

330 Ft. from E. Line

 Ft. from W. Line

Barber

Location

Rig up

Drilling and Remarks:

reported
NE SE SW

RECORD

Cased in., ft.

Sand

Gas

Oil

Total Depth

PRODUCTION

1st 24 hrs. Nat.

1st 24 hrs. after shot

Gas Cu. Ft.

Dry Hole

Abandoned

Date

FEB 7 1945 19

S. J. LEWIS

Scout

Pool Name _____
 Twp _____
 Range _____
 Section _____
 Contractor _____
 Company _____

SECTION PLAT

_____ N. Line
 _____ E. Line
 _____ S. Line
 _____ W. Line

RECORD

Cases _____
 Sand _____

- Misc. Small Maps _____
- Cards *Healy* _____
- Tracing *Bob* _____
- France Map *LR* _____
- Scarborough Map _____
- Pierce Map _____
- Geological Dept. _____
- Pierce Plat Book _____

Kansas Pool Name Marjorie

Map No. 92 Sec. 28 Twp. 30 R. 13W

Well No. 1 Clay

Huber Oil Company

COMPLETE Contractor

CEL SE SW

E. 11886
SECTION PLAT

 Ft. from N. Line

660 Ft. from S. Line

330 Ft. from E. Line

 Ft. from W. Line

Barber

Location

Rig up

Drilling and Remarks:

*Log 3967
Misc 4418.
Sump Sol 4717
F-10 4625.
202 to 4583-59
5750 acid
Flow 240 12X
40° br*

RECORD

Cased in., ft.

Sand

Gas

Oil

Total Depth 4730

PRODUCTION

1st 24 hrs. Nat.

1st 24 hrs. after shot

Gas Cu. Ft.

Dry Hole

Abandoned

Date

MAY 23 1945 19

S. J. LEWIS Scout



- Misc. Small Maps _____
- Cards _____ *[Signature]*
- Tracing _____ *[Signature]*
- France Map _____ *[Signature]*
- Scarborough Map _____ *[Signature]*
- Pierce Map _____ *[Signature]*
- Geological Dept. _____
- Pierce Plot Book _____