


KANSAS

Barber County

Section 28 Township 30 Range 13W

Well No. #1 Lemon

Company Lion Oil Ref.

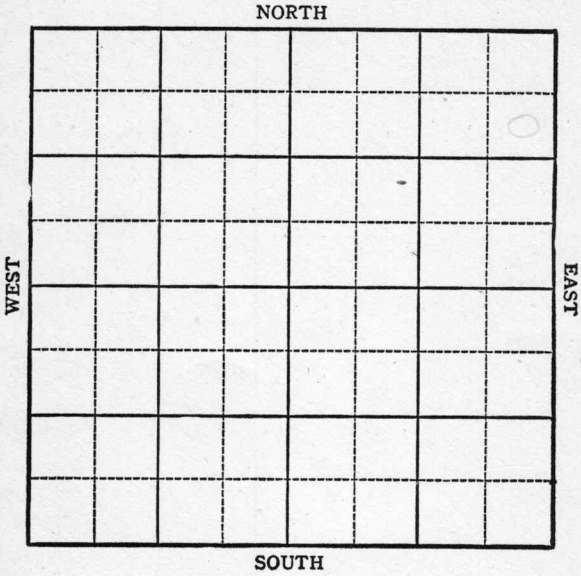

KANSAS Barber County

Sec. 28 Twp. 30 R. 13W

Well No. #1 Lemon Farm

Lion Oil Ref. Company


Wildcat

990 Ft. from N. Line

Ft. from S. Line

330 Ft. from E. Line

Ft. from W. Line

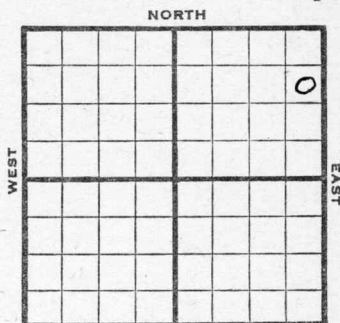

SE NE NE Elev. 1871

1944

R E P O R T

11/15

RUR

11/24

surface hole

11/29

8" @ 749 Drlg. 2400

12/6

Drlg. 3180'

12/14

Lans 3962

Drlg. 4068'

12/21

Drlg. 4287'

12/29

Miss 4361

Drlg. 4606

1945

1/3

Simp sh4638

Arb 4736

TD 4848 run csg

1/10

5" @ 4598 RUST

1/17

Arb 4736

5" @ 4598

PB 4578

48 shots 4528-4545

1000 acid

TD 4848


18 M Gas

COMPLETED

Pool Name WildcatMap No. 92 Sec. 28 Twp. 30 R. 13WWell No. 1 LemonLion Oil Ref. CompanyFIRST REPORT Contractor

S E NE NE

SECTION PLAT

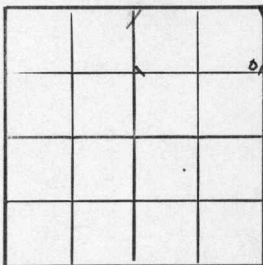990 Ft. from N. Line Ft. from S. Line330 Ft. from E. Line Ft. from W. Line

Barber

Location Rig up

Drilling and Remarks:

R U R

RECORD

Cased in., ft.Sand Gas Oil Total Depth

PRODUCTION

1st 24 hrs. Nat. 1st 24 hrs. after shot Gas Cu. Ft.Dry Hole Abandoned

Date

NOV 15 1944

19

S. J. LEWIS Scout

KANSAS

Pool Name WildcatMap No. _____ Sec. 23 Twp. 30 R. 13WWell No. 1 Lemon

Lion Oil Ref.


Company

COMPLETED

Contractor

SE NE NE

SECTION PLAT

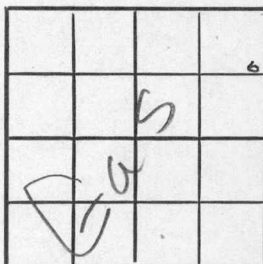990 Ft. from N. Line

Ft. from S. Line

330 Ft. from E. Line

Ft. from W. Line

Barber

RECORD

Location _____

Cased _____ in., _____ ft.

Rig up _____

Sand _____

Drilling and Remarks:

Gas _____

CR 8 4286

Oil _____

5" 4598Total Depth 4848.928 4598.

PRODUCTION

48 shots 4528-45.

1st 24 hrs. Nat. _____

1000 acid

1st 24 hrs. after shot _____

15 M Gas

Gas _____ Cu. Ft.

Dry Hole _____

Abandoned _____

Date

JAN 17 1945 19

S. J. LEWIS

Scout