

KANSAS

Barber

Section 28 Township 30 Range 14W

Well No. 1 Warner "C" *(Werner)*

Company Great Lakes Carbon

O. W. D. D

No Name

NORTH

WEST

EAST

				0			

SOUTH

KANSAS

Barber

Sec. 28 Twp. 30 R. 14W ✓

Well No. 1 Warner "C" Farm

Great Lakes Carbon Company

No Name O. W. D. D Coppinger - Contr.


330 Ft. from N. Line

 Ft. from S. Line

 Ft. from E. Line

330 Ft. from W. Line

NW NE

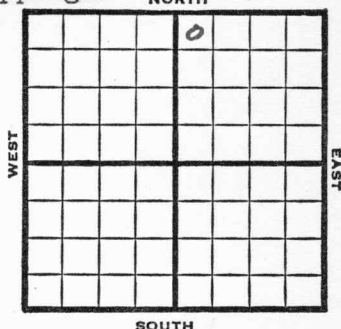

1949 Elev. 1843' REPORT

9/28 Surface Hole
10/5 8" @ 755'
Drlg 2505'
10/12 Drlg 3535'
10/19 KC 3910'
Drlg 4399'
10/26 Simp 4510'
5" @ 4517' TD
11/1 TD 4550'
2,530,000 Gas
1000 acid
11/9 16 qts 4522'-30 CO
11/23 TD 4530'
Simp 4510'
Aband.

ABANDONED

1950 **O. W. D. D**

2/8 Simp 4517
TD 4530'
5" @ 4517'
Moving in tools
3/15 TD 4542'
5" @ 4517'
Drlg deeper to 4542 in Simp
D&A
Aband.

ABANDONED

Map No. _____ Sec. 28 Twp. 30 R. 14W

Well No. 1 Warner "C"

Great Lakes Carbon Company

Coppinger Contractor

NW NE


FIRST REPORT
SECTION PLAT

330 Ft. from N. Line

_____ Ft. from S. Line

_____ Ft. from E. Line

330 Ft. from W. Line

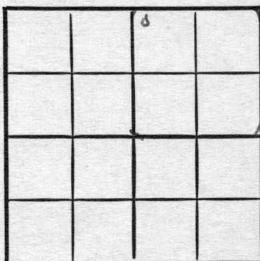

Barber County

Location _____

Rig up _____

Drilling and Remarks:

surface hole

RECORD

Cased _____ in., _____ ft.

Sand _____

Gas _____

Oil _____

Total Depth _____

PRODUCTION

1st 24 hrs. Nat. _____

1st 24 hrs. after shot _____

Gas _____ Cu. Ft.

Dry Hole _____

Abandoned _____

Date

SEP 28 1949 19

S. J. LEWIS Scout

Kansas

No name

Map No. _____ Sec. 28 Twp. 30 R. 14WWell No. 1 Werner "C"

Great Lakes Carbon _____ Company

ABANDONED

Contractor

NW NE

E 1/1848
SECTION PLAT330 Ft. from N. Line

_____ Ft. from S. Line

_____ Ft. from E. Line

330 Ft. from W. Line

		6	

Barber County

Location _____

Rig up _____

Drilling and Remarks:

Sing 4510

RECORD

Cased _____ in., _____ ft.

Sand _____

Gas _____

Oil _____

Total Depth 4530

PRODUCTION

1st 24 hrs. Nat. _____

1st 24 hrs. after shot _____

Gas _____ Cu. Ft.

Dry Hole _____

Abandoned _____

Date

NOV 23 1949

19

S. J. LEWIS

Scout

NOV 25 1949

NOV 25 1949

Scout Cards *Edith*
Land Small Map
Land Wall Map *33*
Tracings
France Map
Pierce Map
Misc.

Scout

Kansas

OWDD

Map No. _____ Sec. 28 Twp. 30 R. 14WWell No. 1 Werner "C"

Huber _____ Company

Was Great Lakes Carbon _____ Contractor


NW NW NE **O. W. D. D**

SECTION PLAT

330 Ft. from N. Line

_____ Ft. from S. Line

_____ Ft. from E. Line

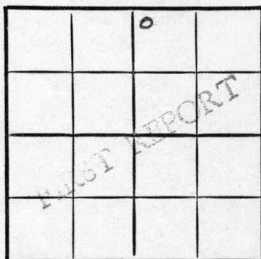330 Ft. from W. Line

Barber County

Location _____

Rig up _____

Drilling and Remarks:

Simp. 4517-30 TD

5" @ 4517

Moving in tools

RECORD

Cased _____ in., _____ ft.

Sand _____

Gas _____

Oil _____

Total Depth _____

PRODUCTION

1st 24 hrs. Nat. _____

1st 24 hrs. after shot _____

Gas _____ Cu. Ft.

Dry Hole _____

Abandoned _____

Date

FEB 8 1950 19J. E. TYRA Scout


Map No. _____ Sec. _____ Twp. _____ R. _____

Well No. _____

Company _____

Contractor _____

SECTION PLAT

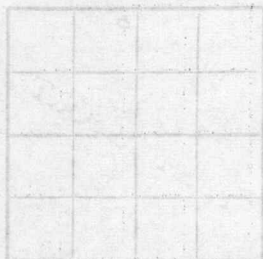

E. from N. Line _____

W. from S. Line _____

E. from E. Line _____

E. from W. Line _____

RECORD

Location _____

Trig. up _____

Drilling and Remarks _____

Scout Cards _____

Land Small Map _____

Land Well Map _____

Tracings _____

France Map _____

Pierce Map _____

Misc. _____

FEB 10 1950

Date _____

J. E. TYRA 1950 10

Kansas

Map No. _____ Sec. 28 Twp. 30 R. 14WWell No. 1 Werner "C"

Huber

Company

Contractor

NW NW NE

E1. 1843
SECTION PLAT330 Ft. from N. Line

Ft. from S. Line

Ft. from E. Line

330 Ft. from W. Line

OWDD

Barber County

		0	
		ABANDONED	

Location _____

Rig up _____

Drilling and Remarks:

5" @ 4517

Drig Deeper to
4542 in Simp

D & A

RECORD

Cased _____ in., _____ ft.

Sand _____

Gas _____

Oil _____

Total Depth 4542

PRODUCTION

1st 24 hrs. Nat. _____

1st 24 hrs. after shot _____

Gas _____ Cu. Ft.

Dry Hole _____

Abandoned _____

Date

MAR 15 1950

19

J. E. TYRA Scout

Address

Map No. _____ Sec. _____ Twp. _____ R. _____

Well No. _____

Company _____

Contractor _____

SECTION PLAT

_____ Ft. from N. Line

_____ Ft. from S. Line

_____ Ft. from E. Line

_____ Ft. from W. Line

OWAD

Other Survey

RECORD

Cased _____ in _____ ft.

Sand _____

Gas _____

Oil _____

Total Depth _____

Location _____

Log up _____

Drilling and Remarks _____

MAR 22 1950

Scout Cards *Edith*
 Land Small Map _____
 Land Wall Map _____
 Tracings _____
 France Map _____
 Pierce Map _____
 Misc. _____

Date

MAR 15 1950