


Section 28 Township 30 Range 11W

Well No. 1 Keimig

Company Aylward Drlg. et al

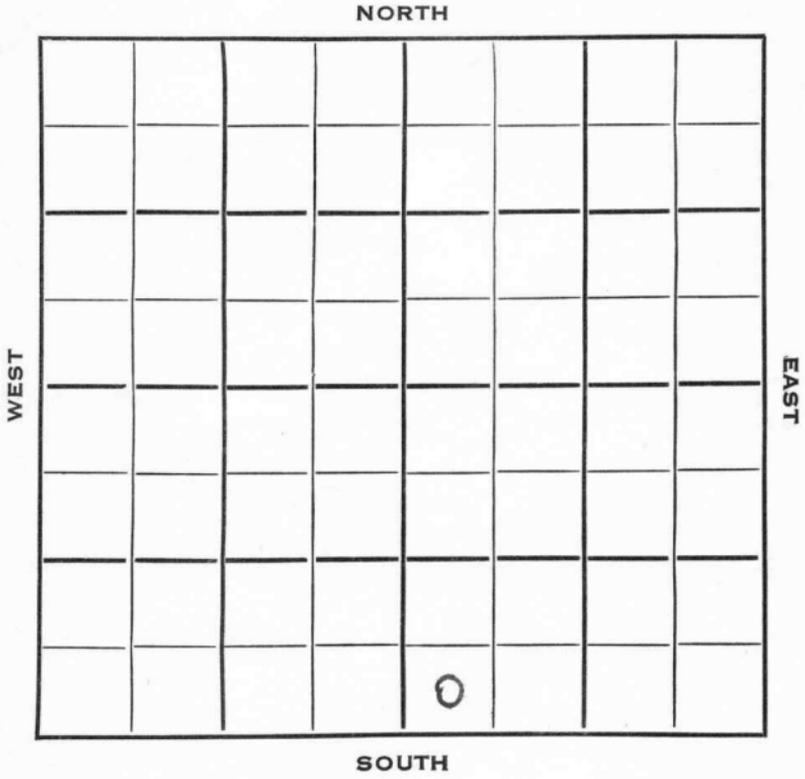


County **Barber** State **Kansas**

Sec. **28** (Blk. Twp.) **30** (Sur. Rge.) **11W** Map No.

Operator **Aylward Drlg. etal.**

Well No. **1** Farm **Keimig**

Elev. Location **SW SW SE**

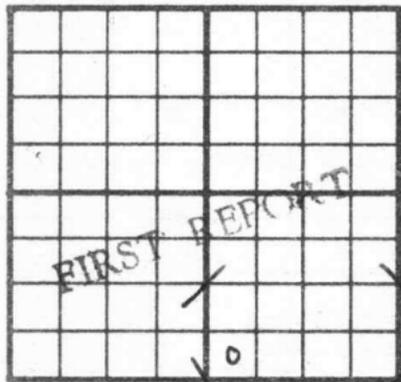

330 Ft. From **S** Line **SE**

330 Ft. From **W** Line Quarter

1st. Report **MAR 21 1954**

Completion

Remarks **MCPC has N/2 of 29**
Aylward Drlg. - Contr.

Spudding Date

Drlg. Data **Wildcat**

Location

County Barber State Kansas

Sec. 28 (Blk. 30) (Sur. 11W) Twp. (Rge.) Map No.

Operator Aylward Drlg. etal.

Well No. 1 Farm Keimig

Elev. 1796 Location SW SW SE



330 Ft. From S Line SE

330 Ft. From W Line Quarter

Ist. Report

Completion APR 28 1954

Remarks Wildcat

Aylward Drlg. - Contr.

Spudding Date 4-3-54

Drlg. Data D & A TD 4870

8" @ 284 Anhy 1770 Elgin 3580

DST 3580-95 open 1 hr. Rec. 20' mud

1100# Doug. 3750 DST 3751-95 open 15 mi

Rec. 2600' sw 1380# Lans. 3878

DST 4258-80 open 40 min. Rec. 45' socm

1580# Miss. 4409 DST 4400-17 open 3/4 h

Rec. 25' mud 45# DST 4400-30 open 3/4

hr. Rec. 5' mud 35# EroViola 4658

Viola 4670 Simp. sh. 4736 Simp. dol. 4738

DST 4735-60 open 1/2 hr. Rec. 7' mud

60# Arb. 4843 DST 4841-70 open 1 hr

Rec. 184& sw 1210# TD 4870

D & A

J. G. McGEHEE