DX 78-1 Kingman

KANSAS

Section 28 Township 30 Range 8W

Well No. #1 Carrick

Company Pickrell Drlg

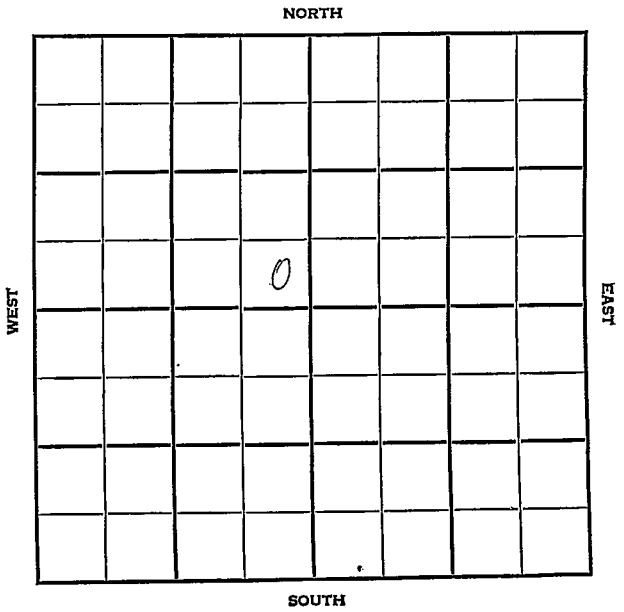

Kingman **KANSAS**

SEC.	TWP.	R.
28	30	8W

WELL NO.

#1 Carrick FARM

COMPANY

Pickrell Drlg.

CONTRACTOR

Spivey

_____ Ft. from N. Line

_____ Ft. from S. Line

_____ Ft. from E. Line

_____ Ft. from W. Line

SE SE NW

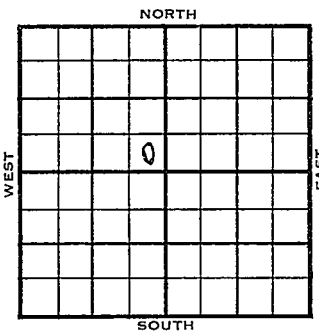

1956	ELEVATION 1623	REPORT

3-21 MIR

6-13 Comm. 3-20-56
8 5/8" @160 w/180
DST 4284-4318, op 1 hr. rec. 185' gcm
1550/ 20"
DST 4323-57, op 1 hr. 2,930 mcfg.
rec. 140' o & gcm 5' wtr. 1515/15"
5½" @4374 w/100
CO to 4352
140/ 4300-35 2,500 mcfg frac
comp. open flow 6,270 mcfgpd
L. 3546', M. 4282'
TD 4377'

COMPLETED

DX-78

FORM 513 REV. SUNRAY

County Kingman Elev.

Sec. 28 Twp. 30 Rge. 8W

Company Plateau Drlg.

Farm Name Connor No. 1

TOPS	DEPTH	LOG	DATUM
Anh.			
Tp.			
H.			
Tr.			
Dg.			
Bl.			
L.			
K.C.			
B.K.C.			
Ce.			
C.			
M.			
M.			
K.			
Mz.			
Mq.			
V.			
S.			
S.			
A			
R.			
P€.			
G.			
T.D.			

Loc. in Sec. SE SE NW

Geol.

Contr.

Pool Survey

MAR 21 '56

0

FIRST REPORT

Date Comm.

M T D

Co. Lse. No. Sec. T. R.

FORM 513 REV. SUNRAY

County Kingman Elev. 1623 Co.

Sec. 28 Twp. 30 Rge. 8W

Company Pickrell Drlg.

Farm Name Carrick No. 1

TOPS	DEPTH	LOG	DATUM
Anh.			
T.P.			
H.			
Tr.			
Dg.			
Bi.			
L.	3546		
K.C.			
B.K.C.			
Ce.			
C.			
M.	4282		
M.			
K.			
Mz.			
Mo.			
V.			
S.			
S.			
A			
R.			
P€.			
G.			
T.D.	4377		

Loc. in Sec. SE SE NW

Geol.

Contr.

Pool Spivey

JUN 13 '56

COMPLETE

Lse. No. Sec. T. R.

Date Comm. 3-20-56

8 5/8" @ 160/180 DST 4284-4318

open 1 hr. rec. 185' gcm 1550/20"

DST 4323-57 open 1 hr. 2,930 mcfg

rec. 140' o. & gcm 5' wtr. 1515/15"

5½" @ 4374/100 CO to 4352 140/ 4300-35

2,500 mcfg frac

Comp. open flow 6,270 mcfgpd