

Kingman

KANSAS

SECTION 28 TOWNSHIP 30 RANGE 8 WWELL NO. #1 Joe Tjaden "E"COMPANY Stanolind

NORTH

				0			

SOUTH

Kingman

KANSAS

SEC.

28

TWP.

30

R.

8W

WELL NO.

#1 Joe Tjaden "E"

FARM

COMPANY

Stanolind

CONTRACTOR

Noble

Spivey


Ft. from N. Line

Ft. from S. Line

Ft. from E. Line

Ft. from W. Line

SW SW SE

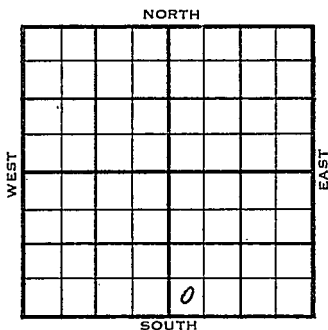

1955

ELEVATION

1587'

REPORT

11/2

Loc

12-21

Comm. 10-29-55

8 5/8" @ 185/250

5 1/2" @ 4449/200

CO to 4424, 32/ 4346-54,

S/ 1 1/2 BOPH, 3 hrs., 500 A

S/ 3/4 BO, 2 1/4 BWPH, 12 hrs.

frac,

S/ 13 BFPH, ~~##~~ 30% BSW,

S/ 3 1/2 bo, 6 1/2 bwph, 12 hrs.

Comp. 169 BOPD, 39% wtr.

M. 4284

TD 4450'

COMPLETED

4284
1587
2697

County Kingman Elev. 1587
 Sec. 28 Twp. 30 Rge. 8W
 Company Stanolind
 Farm Name Joe Tjaden "E" No. 1

TOPS	DEPTH	LOG	DATUM	Loc. in Sec.
Anh.				SW SW SE
TP.				
H.				
Tr.				
Dg.				
BL.				
L.				Geol.
K.C.				Contr.
B.K.C.				Noble
Ce.				Pool
C.				Spivey
M.	4284		2697	
M.				
K.				
Mz.				
Ma.				
V.				
S.				
S.				
A.				
R.				
Pe.				
G.				
T.D.	4450			

COMPLETE

Date Comm. 10-29-55 DEC 21 1955

8 5/8" @ 185/250 5 1/2" @ 4449/200

CO to 4424 32/ 4346-54 S/ 1 1/2 boph

3 hr. 500 A S/ 3/4 bo 2 1/4 bwph 12 hr.

frac S/ 13 bfph 30% bsw S/ 3 1/2 bo

6 1/2 bwph 12 hr. Comp. 169 bopd 39% wtr.

201 /
 513

JAN 4 1956

R. G.

County Kingman Elev. _____
 Sec. 28 Twp. 30 Rge. 8W
 Company Stanford
 Farm Name Joe Tjaden "E" No. 1

TOPS	DEPTH	LOG	DATUM	Loc. in Sec.
Anh.				SW SW SE
Tr.				
H.				
Tr.				
Dg.				
Bl.				
L.				
K.C.				Geol.
B.K.C.				Contr.
Ce.				Noble
C.				
M.				Pool
M.				Spivey
K.				
Mz.				
Mq.				
V.				
S.				
S.				
A.				
R.				
Pe.				
G.				
T.D.				

FIRST REPORT

NOV 2 '55

0

Date Comm.

Location

27

NOV 7 1955

Scout Cards	<u>mm</u>
Land Small Map	_____
Land Wall Map	_____
Tracings	_____
France Map	_____
Pierce Map	_____
Misc.	_____