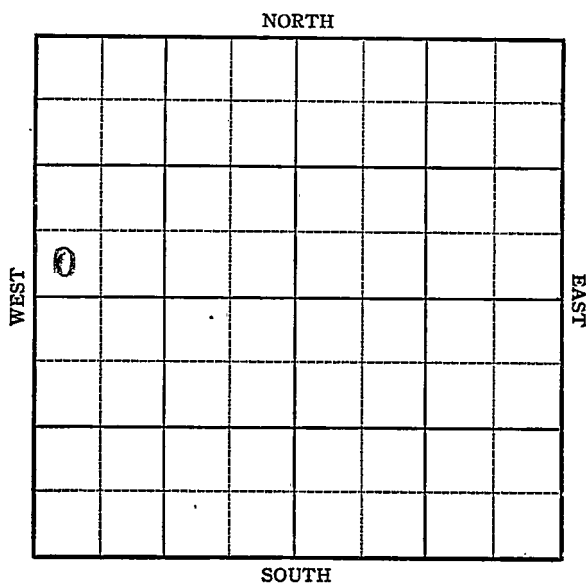


KANSAS

Kingman County

FORM 51 5M PETROL

Section 28 Township 30 Range 8WWell No. 1 GarrickCompany Vickers

KANSAS

Kingmen

Sec. 28 Twp. 30 R. 8W

Well No. 1 Carrick Farm

Vickers Company

Wildcat


_____ Ft. from N. Line

430 _____ Ft. from S. Line

_____ Ft. from E. Line

330 _____ Ft. from W. Line

SW NW Elev. 1641

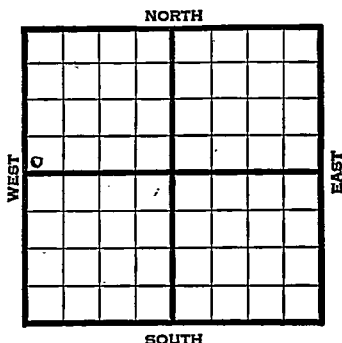

1945

REPORT

6/9 10^m -168 800'

5/17 Drlg. 2520

5/24 Drlg. 2840

5/31 Miss 4296

Tight hole

6/13 Topeka 2930.

Lms 3580

BKC 4036 -

Miss 4328

Viola 4644

Arb 4816

5" @ 4580

TD 4853.

ABANDONED

Kansas Pool Name WildcatMap No. 36 Sec. 28 Twp. 30 R. 8WWell No. 11 aprickVickers


Company

FIRST REPORT

Contractor

SW NW

SECTION PLAT

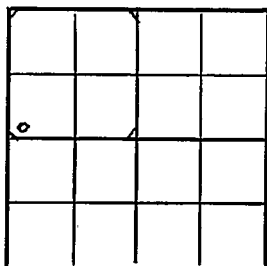 Ft. from N. Line430 Ft. from S. Line Ft. from E. Line330 Ft. from W. LineKingmanLocation Rig up

Drilling and Remarks:

10"-168 800'

RECORD

Cased in. ft.Sand Gas Oil Total Depth

PRODUCTION

1st 24 hrs. Nat. 1st 24 hrs. after shot Gas Cu. Ft.Dry Hole Abandoned

Date

MAY 9 1945

19


S. J. LEWIS

Scout

Kansas Pool Name WildcatMap No. 56 Sec. 28 Twp. 30 R. 8WWell No. 1 CarrickVickers Company**ABANDONED**

Contractor

SW NW

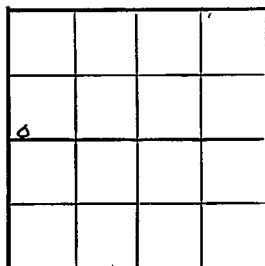E 1/4
SECTION PLAT Ft. from N. Line430 Ft. from S. Line Ft. from E. Line330 Ft. from W. LineKingman CountyLocation Rig up

Drilling and Remarks:

Top of ke 2930L-m 3050BKC 4036Mis 4328Vick 4646Per 48765' @ 4588**RECORD**Cased in., ft.Sand Gas Oil Total Depth 4853**PRODUCTION**1st 24 hrs. Nat. 1st 24 hrs. after shot Gas Cu. Ft.Dry Hole Abandoned

Date

JUN 13 1945

19

S. J. LEWIS Scout