

Kingman


KANSAS

SECTION 28 TOWNSHIP 30 RANGE 8W

WELL NO. #1 A.R. Carrick

COMPANY Stanolind

NORTH

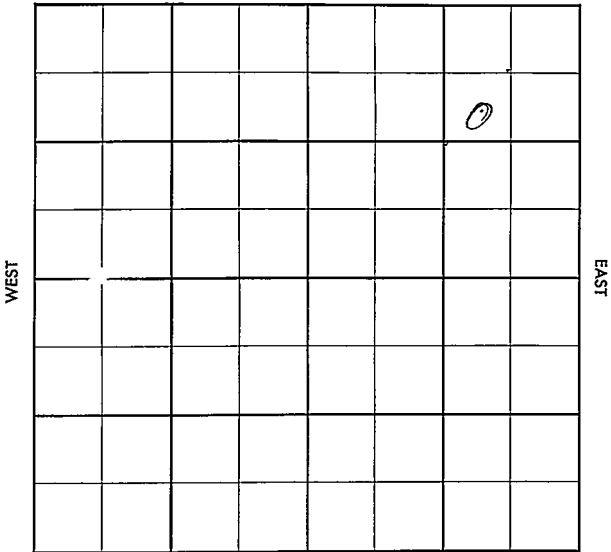

SOUTH

County Kingman Elev. _____
 Sec. 28 Twp. 30 Rge. 8W
 Company Stanolind
 Farm Name A. R. Carrick No. 1

TOPS	DEPTH	LOG	DATUM	Loc. in Sec.
Anh.				SW NE NE
Tp.				
H.				
Tr.				
Dg.				
Bl.				
L.				Geol. _____
K.C.				Contr. _____
B.K.C.				
Ce.				<u>Herndon</u>
C.				Pool _____
M.				<u>Solvey-Grabs</u>
M.				
K.				
Mz.				
Me.				
V.				
S.				
S.				
A				FIRST REPORT
R.				
PE.				DEC 19 1955
G.				
T.D.				

Date Comm. 12-75-56
8" @ 195/250 drlg. 1275

~~27~~

Co.
 Use
 No.
 Sec.
 T.
 R.

Co.

Loc.

No.

Stk.

I.

R.

County Kingman Elev. 1555
 Sec. 28 Twp. 30 Rge. 8W
 Company Stanolind
 Farm Name A. E. Garrick No. 1

TOPS	DEPTH	LOG	DATUM	Loc. in Sec.
Anb.				SW NE NE
Tp.				
H.				
Tr.				
Dg.				
Bl.				
L.				
K.C.				Geol.
BXC.				Contr.
Ce.				<u>Herndon</u>
C.				
M.	<u>4234</u>			Pool
M.				<u>Spivey-Grabs</u>
K.				
Mz.				
Mo.				
V.				
S.				
S.				
A.				
R.				
PE.				
G.				
TD.	<u>4480</u>			

JAN 30 57
 COMPLETE

Date Comm. 12-15-56
 8" @ 195/250 drlg. 1275 DEC 26 56 @ 3330

JAN 2 '57 DST 4235-50 1hr 6/2"
 ga. 2,250 MCF neg 20' GCWM
 BHP 1525/30' 6" @ 4399/250
 JAN 9 '57 CO 4367 16/ 4286-90
 Ma \$ 1 Boph no/w Frac
 \$ 5 Flowd 20 Boph + 2070 wh
 ga 1,500 MCF RD 60K 3100/1
 JAN 9 '57 707 JAN 30 Ph Flow

209 Bopd + 20 BWpd

+ gas ga 1,750 MCFGPA

GOR ~~8397~~ 8397:1)