

KANSAS

Haskell

Section 28 Township 30 Range 33W

Well No. 1 Hickman "B"

Company Terminal Service

Hugoxton

NORTH

WEST

EAST

SOUTH

KANSAS

Haskell ✓

Sec. 28 Twp. 30 R. 33W

Well No. 1 Hickman "B" Farm _____

Terminal Service

Hugoton Pool Lohman & Johnson ^{NORTH} Contr. Company


_____ Ft. from N. Line

100 Ft. from S. Line

100 Ft. from E. Line

_____ Ft. from W. Line

SE NW

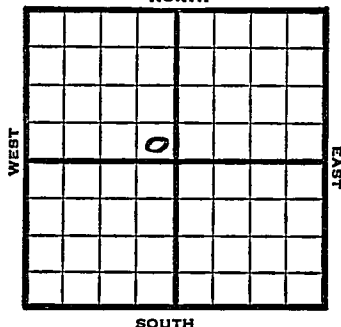

1949 Elev 2942' REPORT

9/28 8" @ 640'
Drlg. 864'
10/5 TD 2791
5" @ 2786'
10/12 "
10/19 230 shots 2638-2730'
2500 acid
10/26 Acid 36,000
11/1 "
11/9 "
11/16 TD 2791'
5" @ 2786'
Perf
36000 acid
14,400,000 Gas
390# R Pr.
Comp

COMPLETED

Map No. _____ Sec. 28 Twp. 30 R. 33W

Well No. 1 Hickman "B"

Terminal Service Company

Lohman & Johnson Contractor

SE NW

FIRST REPORT
SECTION PLAT

_____ Ft. from N. Line

100 Ft. from S. Line

100 Ft. from E. Line

_____ Ft. from W. Line

Haskell County

Location _____

Rig up _____

Drilling and Remarks:

8" @ 640

drlg. 864

RECORD

Cased _____ in., _____ ft.

Sand _____

Gas _____

Oil _____

Total Depth _____

PRODUCTION

1st 24 hrs. Nat. _____

1st 24 hrs. after shot _____

Gas _____ Cu. Ft.

Dry Hole _____

Abandoned _____

Date

SEP 28 1949 19

S. J. LEWIS

Scout

Map No. _____ Sec. 28 Twp. 30 R. 33W

Well No. 1 Hickman "B"

Terminal Service Company

COMPLETE

Contractor

SE NW


E1, 2944
SECTION PLAT

_____ Ft. from N. Line

100 Ft. from S. Line

100 Ft. from E. Line

_____ Ft. from W. Line

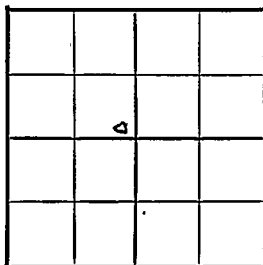

Haskell County

Location _____

Rig up _____

Drilling and Remarks:

5" @ 2786
Perf.
26000 cu ft
14,400,000 gal

390# R/A

RECORD

Cased _____ in., _____ ft.

Sand _____

Gas _____

Oil _____

Total Depth 2781

PRODUCTION

1st 24 hrs. Nat. _____

1st 24 hrs. after shot _____

Gas _____ Cu. Ft.

Dry Hole _____

Abandoned _____

Date

NOV 16 1949 19

S. J. LEWIS Scout