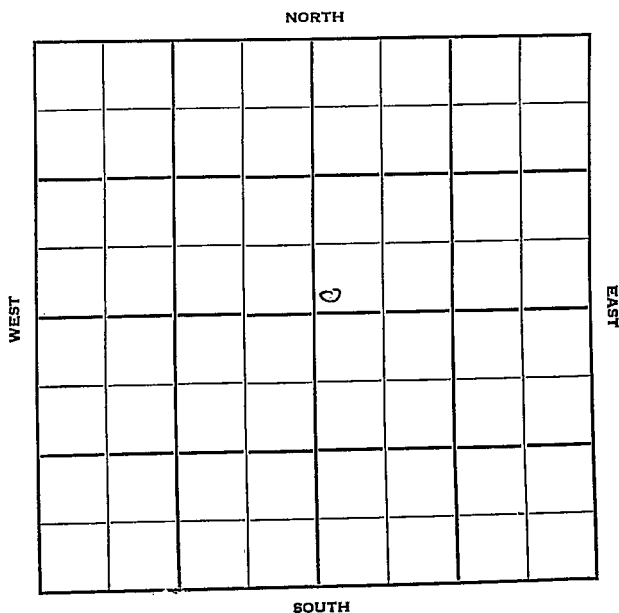


Section 28 Township 30 Range 32WWell No. #1 G. W. AveryCompany Northern Pump

Sec. 28 Twp. 30 R. 32W ✓

Well No. #1 G. W. Avery Farm

Northern Pump Company

Contractor

Ft. from N. Line

150


150 _____ Ft. from S. Line

Ft. from E. Line

150

150 Ft. from W. Line

SW SW NE

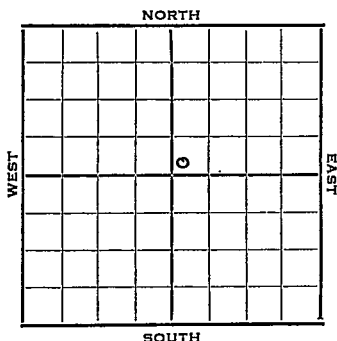

1952

Elev. 2873

REPORT

✱

5/28	Location
------	----------

6/11 11

6/18 11

6/25	11
------	----

7/2	11
-----	----

7/9 10" @ 601 RTD 2640' 7" @ 2624'

7/17 NR

7/23	12
------	----

7/30 DD @ 2645

8/6 DP 2704 1500 A DD @ 2730

8/13	TD 2730'	18,250 A
------	----------	----------

8/20	Spud 6-19-52	Gas Well	TD 2730
------	--------------	----------	---------

10" @ 601 7" @ 2624 TD 2645

DD 2704 1500 A DD 2730 1500 A

1000 A Her. 2632 Kri 2648

Win 2705 16,000 A

Comp. 3,430,000 gas


COMPLETED

County **Haskell** State **Kansas**
 Sec. **28** (Blk. Twp.) **30** (Sur. Rge.) **32W** Map No.

Operator **Northern Pump**

Well No. **1** Farm **G. W. Avery**

Elev. Location **SW SW NE**

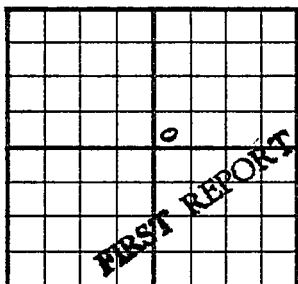

150 Ft. From **S** Line **NE**

150 Ft. From **W** Line Quarter

1st. Report **MAY 28 1952**

Completion

Remarks


Spudding Date

Drig. Data

Location

J. G. McGEHEE

County Haskell State Kansas
 Sec. 28- (Blk.) 30 (Sur.) 32W Map No.
 Operator Northern Pump
 Well No. 1 Farm G. W. Avery
 Elev. 2873 Location SW SW NE

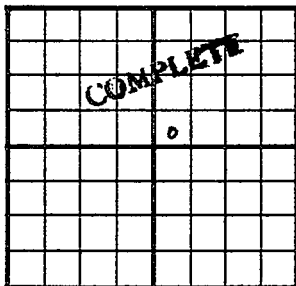

150 Ft. From S Line NE

150 Ft. From W Line Quarter

1st. Report

Completion AUG 20 1952

Remarks

Spudding Date 6-19-52

Drlg. Data Gas well TD 2730
10" @ 601 7" @ 2624 TD 2645 DD 2704
1500 A DD 2730 1500 A 1000 A
Her. 2632 Kri. 2648 Win. 2705
16000 A Comp. 3,430,000 gas