FORM 51 25M 3-49 PETROL

KANSAS


Grant

Section 28 Township 30 Range 38W

Well No. 1 Matzen

Company Hugoton Prod.

Hugoton

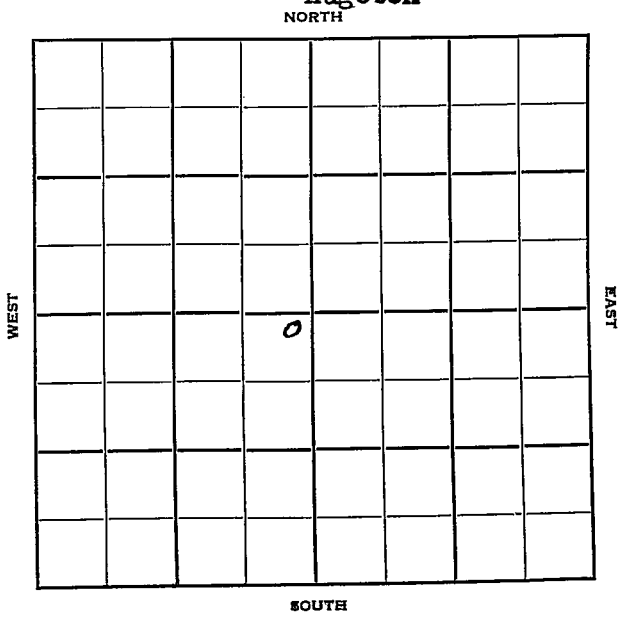

FORM 252-A
5M 10-48 PETROL

KANSAS Grant

Sec. 28 Twp. 30 R. 38W

Well No. #1 Matzen Farm

Hugoton Prod. Company

Hugoton Pool (Burris, Cont.)


100' Ft. from N. Line

Ft. from S. Line

100' Ft. from E. Line

Ft. from W. Line

NE SW

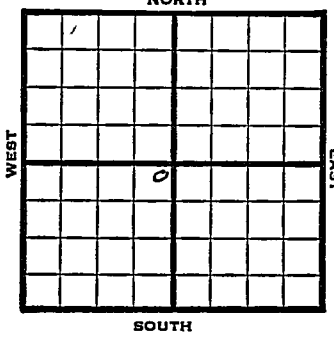

1949	Elev 3171' REPORT
6/22	Location
6/28	"
7/6	"
7/12	"
7/20	10":@ 620' Drlg 972'
7/27	TD 2445' 7"@ 2535'
8/3	Drlg. 2625'
8/10	258' of 5" Perf liner @ 2657' TD
8/17	TD 2657' 7"@ 2435' 258' of 5" Perf Liner @ 2651' 4,301,000 Gas 425# R Pr. Comp

COMPLETED

Form 26 200 Bks. 9-48 Petrol

Kansas

Hugoton Pool

Map No. _____ Sec. 28 Twp. 30 R. 38W

Well No. 1 Matzen

Hugoton Prod. Company

Burris Contractor

NE SW

100 Ft. from N. Line

_____ Ft. from S. Line


100 Ft. from E. Line

_____ Ft. from W. Line

Grant County

SECTION PLAT

FIRST REPORT

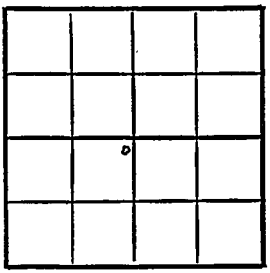

Location X

Rig up

Drilling and Remarks:

RECORD

Cased _____ in., _____ ft.

Sand

Gas

Oil

Total Depth

PRODUCTION

1st 24 hrs. Nat.

1st 24 hrs. after shot

Gas _____ Cu. Ft.

Dry Hole

Abandoned

Date

JUN 2 2 1949 19

S. J. LEWIS Scout

Form 26 200 Bks. 6-49 Petrol

Kansas

Hugoton Pool

Map No. ____ Sec. 28 Twp. 30 R. 38W

Well No. 1 Matzen

Hugoton Prod. Company


COMPLETE

Contractor

E.3171

NE SW

SECTION PLAT

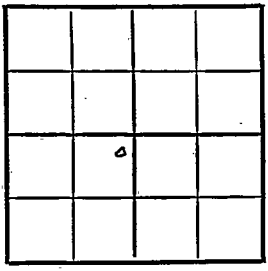

100 Ft. from N. Line

Ft. from S. Line

100 Ft. from E. Line

Ft. from W. Line

Grant County

Location

Rig up

Drilling and Remarks:

7" @2435'

255 sx 5" Pat liner

@2457

4,301,000 Gas

425# RP

RECORD

Cased ____ in., ____ ft.

Sand

Gas

Oil

Total Depth 2457

PRODUCTION

1st 24 hrs. Nat.

1st 24 hrs. after shot

Gas ____ Cu. Ft.

Dry Hole

Abandoned

Date

AUG 17 1949 19

S. J. LEWIS Scout