

KANSAS


FORM 51 IOM 12-46 PETROL

Stanton county

Section 28 Township 30 Range 39-W

Well No. #1, Collingwood "B"

Company Stanolind Oil and Gas Company

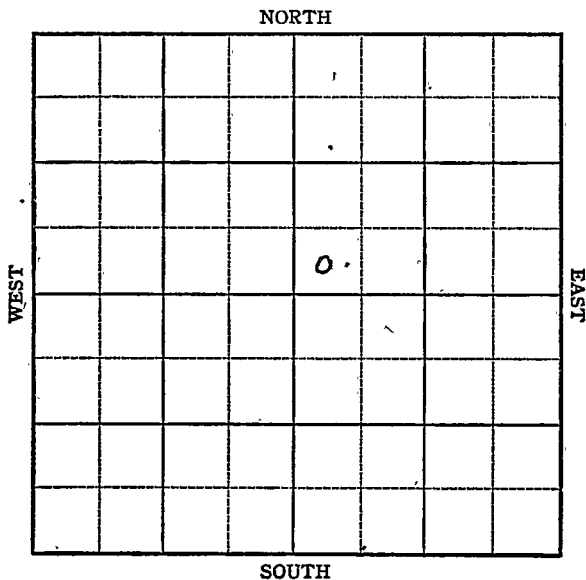

KANSAS

Stanton county

Sec. 28 Twp. 30 R. 39-W

Well No. #1, Collingwood "B" Farm

Stanolind Oil and Gas Company Company


Hugoton Pool

Ft. from N. Line

100' Ft. from S. Line

Ft. from E. Line

100' Ft. from W. Line

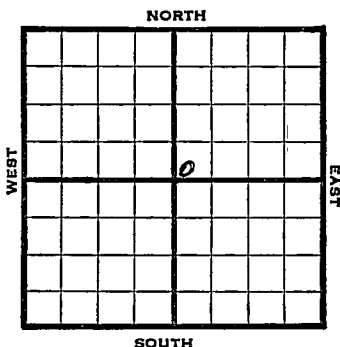

SW NE

1946	Elev. 3206	REPORT
12/18	Drlg. 613'	
	Run Csg.	
1947		
1/4	8" @ 604'	
	TD 2 590'	
	5" @ 2539,	RUST
1/8	500 acid	
	Plug 2530'	
	102 shots 2485-12,	4000 acid
	Plug 2475-192	shots 240-52
	5000 acid	
1/15	188 shots 2355-2403	
	6000 acid	
1/21	" "	
1/30	" "	
2/5	" "	
2/12	" "	
2/19	" "	
2/26	" "	

OVER

3/4 5" @ 2539
Perf
15,000 Acid
10 W Gas

COMPLETED

Kansas

KANSAS

Hugoton Pool

Map No. _____ Sec. 28 Twp. 30 R. 39W

Well No. 1 Collingwood "B"

Stanolind

Company

FIRST REPORT

Contractor

SW NE

SECTION PLAT

		o	

_____ Ft. from N. Line

100 _____ Ft. from S. Line

_____ Ft. from E. Line

100 _____ Ft. from W. Line

Stanton County

Location _____

Rig up _____

Drilling and Remarks:

613 run csg.

RECORD

Cased _____ in., _____ ft.

Sand _____

Gas _____

Oil _____

Total Depth _____

PRODUCTION

1st 24 hrs. Nat. _____

1st 24 hrs. after shot _____

Gas _____ Cu. Ft.

Dry Hole _____

Abandoned _____

Date

DEC 1 8 1946 19

S. J. LEWIS Scout

Misc. Small Maps PAH
 Cards Sarah
 Tracing _____
 France Map X
 Scarborough Map X
 Pierce Map X
 Geological Dept. _____
 Pierce Plat Book _____

KANSAS
Kansas

Hugoton Pool

Map No. _____ Sec. 28 Twp. 30 R. 39WWell No. 1 Collingwood "B"

Stanolind _____ Company


COMPLETE

Contractor

SW NE

E13206

SECTION PLAT

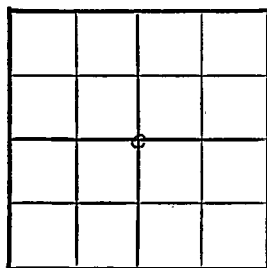

_____ Ft. from N. Line

100 Ft. from S. Line

_____ Ft. from E. Line

100 Ft. from W. Line

Stanton County

Location _____

Rig up _____

Drilling and Remarks: _____

*5' @ 2539**Per J.**15000 cu. ft.**10 ft. Gas.*

RECORD

Cased _____ in., _____ ft.

Sand _____

Gas _____

Oil _____

Total Depth 2539

PRODUCTION

1st 24 hrs. Nat. _____

1st 24 hrs. after shot _____

Gas _____ Cu. Ft.

Dry Hole _____

Abandoned _____

Date

MAR 5 1947 19

S. J. LEWIS Scout

Misc. Small Maps ☒
 Cards ☒
 Tracing ☒
 France Map ☒
 Scarborough Map ☒
 Pierce Map ☒
 Geological Dept. ☐
 Pierce Plat Book ☐