


Section 28 Township 30 Range 142 W

Well No. #1 K. U. Unit

Company Superior Oil Co.

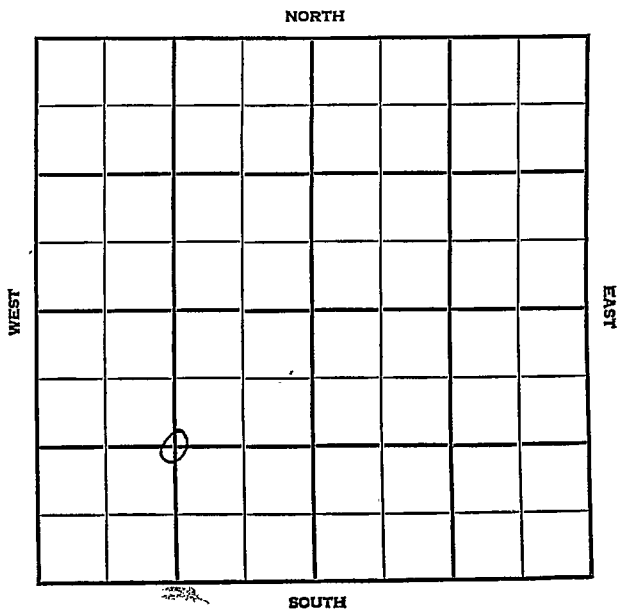

SEC.	TWP.	R.
28	30	42W

WELL NO. #1 K. U. Unit FARM

COMPANY Superior Oil Co.

CONTRACTOR

## Sparks


\_\_\_\_\_ Ft. from N. Line

\_\_\_\_\_ Ft. from S. Line

\_\_\_\_\_ Ft. from E. Line

\_\_\_\_\_ Ft. from W. Line

C SW $\frac{1}{4}$

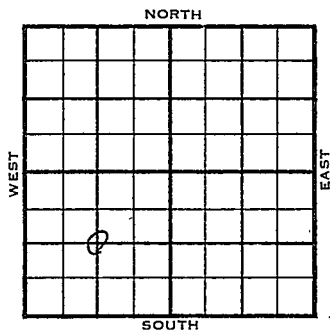

$\frac{1}{4}$  mile SDX

	ELEVATION	REPORT
1955	3557'	
9/21	Loc	
9-29	"	
10-6	Spud 10-2-55 Drlg. 1366	
10-13	10 $\frac{3}{4}$ " @ 1516/ 800 Drlg. 3232'	
10-20	Drlg. 4394'	
10-27	Morrow 5187, Miss. 5354 Drlg. @ 5360'	Morrow sd. 5255,
11-3	7" @ 5385/300, CO to 5355, 144/ 5266-84, 80/ 5295-5305 250 A	
11-10	Frac, S/down, F/ 3,240 mcfg, F/ 3,120 mcfg, 1 hr. 3,120 mcfg in 1 $\frac{1}{2}$ hrs., F/ 4,620 mcfg in 1 $\frac{1}{2}$ hrs., F/ 4150 mcfg.	
11-16	Comp. op flow/ 7,120 mcfgpd	

COMPLETED

County Stanton Elev. \_\_\_\_\_  
 Sec. 28 Twp. 30 Rge. 12W  
 Company Superior Oil Co.  
 FarmName K. U. Unit No. 1

TOPS	DEPTH	LOG	DATUM
Anh.			
Tp.			
H.			
Tr.			
Dg.			
Bl.			
L.			
K.C.			
B.K.C.			
Ce.			
C.			
M.			
M.			
K.			
Mz.			
Mo.			
V.			
S.			
S.			
A.			
R.			
PE.			
G.			
T.D.			

Loc. in Sec. \_\_\_\_\_  
C SW/4  
 Geol. \_\_\_\_\_  
 Contr. \_\_\_\_\_  
 Pool \_\_\_\_\_  
Sparks  
 FIRST REPORT  
 SEP 21 1955

Date Comm. Loc.

*[Handwritten signature/initials]*

Co.  
Lse.  
No.  
Sec.  
T.  
R.

County Stanton Elev. 3557  
 Sec. 28 Twp. 30 Rge. 42W  
 Company Superior Oil  
 Farm Name K. U. Unit No. 1

TOPS	DEPTH	LOG	DATUM	Loc. in Sec.																														
Anb.				C SW/4																														
TP.																																		
H. <u>MARSH</u>	<u>5187</u>	<u>5191</u>	<u>1634</u>																															
Tr. <u>MARSH</u>	<u>5255</u>	<u>5264</u>	<u>1717</u>																															
Dg.																																		
BL.																																		
L.				Geol.																														
K.C.				Contr.																														
B.K.C.																																		
Ce.																																		
C.																																		
M.	<u>5354</u>	<u>5370</u>	<u>1813</u>	Pool																														
M.				Sparks																														
K.																																		
Mz.				<table border="1"> <tr><td></td><td></td><td></td></tr> <tr><td></td><td></td><td></td></tr> <tr><td></td><td></td><td></td></tr> <tr><td></td><td></td><td></td></tr> <tr><td></td><td></td><td></td></tr> <tr><td></td><td></td><td></td></tr> <tr><td></td><td></td><td></td></tr> <tr><td></td><td></td><td></td></tr> <tr><td></td><td></td><td></td></tr> <tr><td></td><td></td><td></td></tr> </table>																														
Ma.																																		
V.																																		
S.																																		
S.																																		
A.																																		
R.																																		
PE.																																		
G.																																		
TD.	<u>5385</u>																																	

Date Comm. 10-2-55 NOV 16 1955

10 3/4" @ 1516/800 7" @ 5385/300

CO to 5355 144/ 5266-84 80/ 5295-5305

250 A frac F/ 3,240 mcfg F/ 3,120  
 mcfg 1 hr. 3,120 mcfg 1 1/2 hr.

F/ 4,620 mcfg 1 1/2 hr. F/ 4,150 mcfg

Comp. open flow/ 7,120 mcfgpd