


Section Kiowa
29 Township 30 Range 19W

Well No. 1 Koehn

Company M. B. Armer

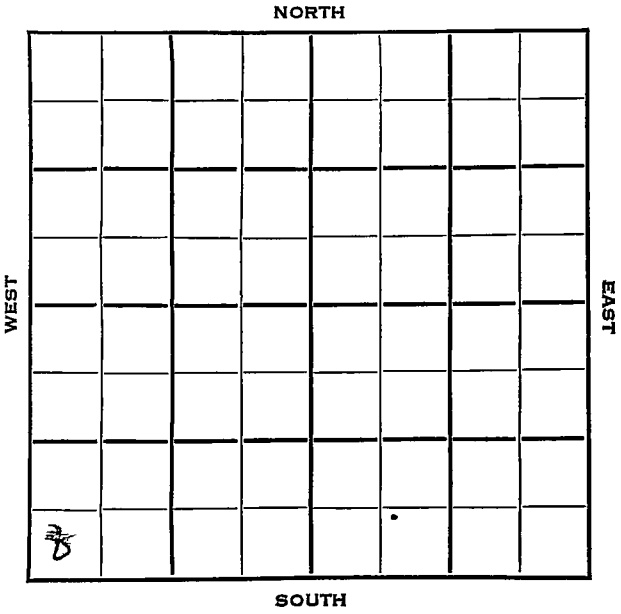

Sec. 29 Twp. 30 R. 19W

Well No. #1 Koehn Farm

M. B. Armer Company

Wildcat Contractor


Ft. from N. Line

330 Ft. from S. Line

Ft. from E. Line

330 Ft. from W. Line

SW SW SW

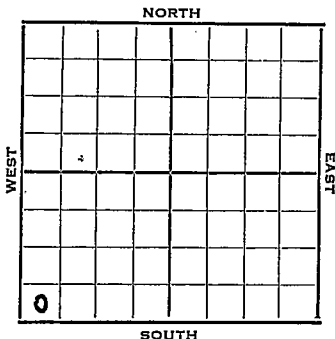

1952 Elev. 2202' REPORT

12/23 Spud 12-22-52
Drlg. 400'

12/25 Drlg. 400'

1953

1/1 Any 1310 Drlg. 2970

1/8 Br li 4408 Lans 4418 Ø 4542

1/11 Spud 12-22-52

D&A TD 5200

8" @ 1023

Anhy 1310, Br lime 4408, Lans 4418, Miss 5037

DST 5039-65, opn 1/2 hr., rec.

10' mud, 130#

TD 5200

D&A

ABANDONED

County Kiowa State KansasSec. 29 (Blk. Twp.) 30 (Sur. Rge.) 19W Map No.Operator M. B. ArmerWell No. 1 Farm KoehnElev. 2202 Location SW SW SW

0					

330 Ft. From S Line SW330 Ft. From W Line Quarter

1st. Report

Completion JAN 14 1953Remarks WildcatSpudding Date 12-22-52Drlg. Data D & A TD 52008" @ 1023 Anhy 1310 Br. lime 4408Lans. 4418 Miss. 5037 DST 5039-65open $\frac{1}{2}$ hr. Rec. 10' mud 130# TD 5200D & A