


Section 29 Township 30 Range 13W

Well No. #1 Larrison

Company Huber Oil

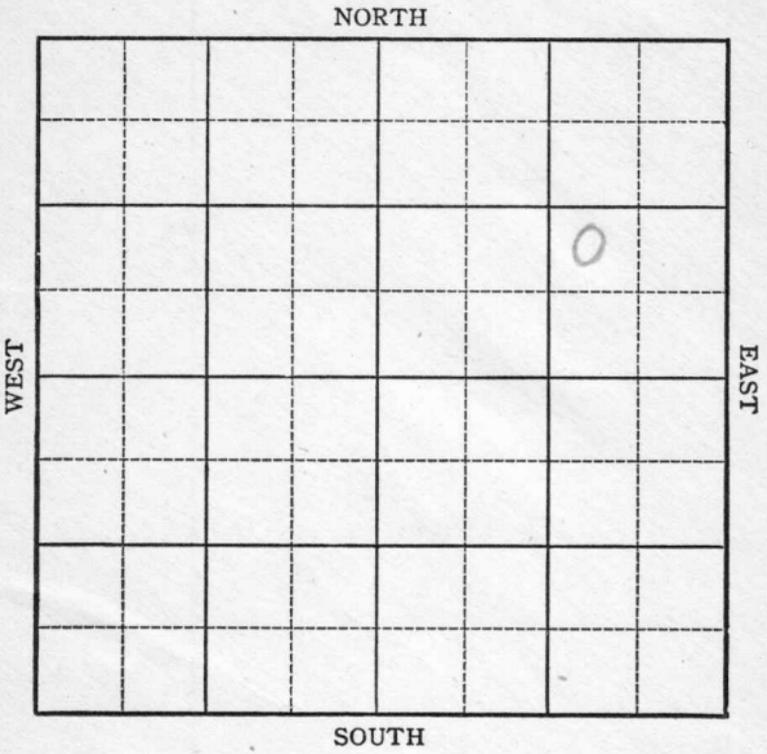

Sec. 29 Twp. 30 R. 13W

Well No. #1 Larrison Farm

Huber Oil Company

Marjorie


Ft. from N. Line

990 Ft. from S. Line

990 Ft. from E. Line

Ft. from W. Line

NW SE NE

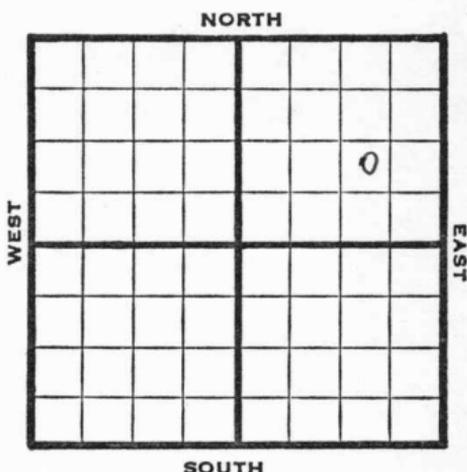

1946

1898

REPORT

- 8/7 Derrick
- 8/13 RUR
- 8/20 10" @ 960 WOC
- 8/27 Drlg 3190'
- 9/5 Drlg 4435'
- 9/10 Lans 3974'
- Miss 4465
- Mag 4577'
- TD 4588
- 5" @ 4579 RUST
- 9/18 " "
- 9/24 " "
- 10/10 " "
- 10/8 " "
- 10/15 Viola 4587'
- TD 4598'
- 1000 acid
- Est 2 M Gas
- 10/22 " "
- 10/29 " "
- 11/6 Viola 4587'
- TD 4598'
- 5" @ 4579'
- 14,000 Acid
- 2 M Gas

COMPLETED

Majorie

1894

Wells No. 1

Huber Oil

Company

Contractor

REPORT

NO. 25

SECTION PLAT

From W. Line

From E. Line

From S. Line

From W. Line

Barber County

Location

Run up

Drilling and Remarks

Derrick

Misc. Small Maps

Cards

Tracing

France Map

Scarborough Map

Pierce Map

Geological Dept.

Pierce Plat Book

[Handwritten signatures and initials over the list of items]

100-1001

From to (to date) 1844-1845
K. N. S.

Map No. 29 - Bar 29

Well No. 1 East 20th

Company _____

Contractor _____

COMPLETED

SECTION PLAT

From N. Line

To from E. Line

To from E. Line

From W. Line

RECORD

Closed _____
 Card _____
 Case _____
 Oil _____

Location _____
 The _____
 Drilling and _____

- Misc. Small Maps _____
- Cards Sand _____
- Tracing mp _____
- France Map ✓ _____
- Scarborough Map ✓ _____
- Pierce Map ✓ _____
- Geological Dept. _____
- Pierce Plat Book _____

Date

NOV. 0