

Barber


KANSAS

SECTION 29 TOWNSHIP 30S RANGE 12 W

WELL NO. #1 Lilliequist

COMPANY Natural Gas & Oil

NORTH C NE NE

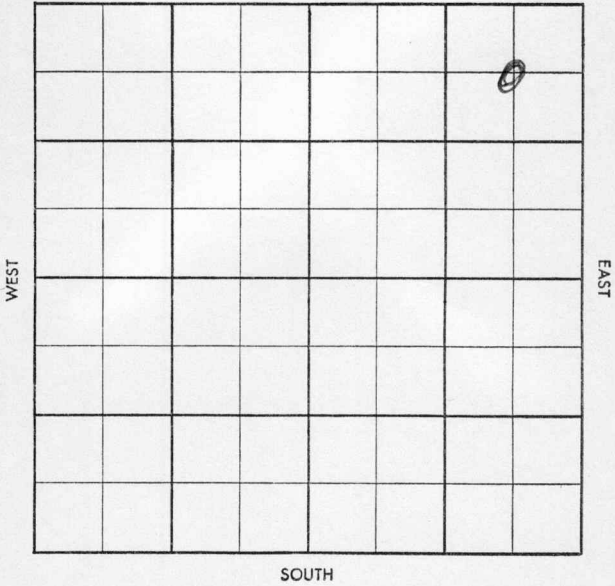

Twp. X Pool X
 Co. X Facet X

S-513.B

County Barber Elev. 1674KB/1671.05
 Sec. 29 Twp. 30 Rge. 12W
 Company Natural Gas & Oil
 Farm Name Lilliequist No. 1

TOPS	DEPTH	LOG	DATUM
Anh.			
Tp.			
H.	<u>3566</u>		
Tr.			
Dg.	<u>54</u>	<u>3587</u>	
B.L.			
L.	<u>3756</u>		
K.C.			
B.K.C.			
Ce.			
C.			
M.	<u>4239</u>		
M.			
K.	<u>4345</u>	<u>4585?</u>	
Mz.			
Mq.			
V.	<u>4452</u>		
S.	<u>5d</u>	<u>4563</u>	
S.			
A.			
R.			
Pf.			
G.			
T.D.	<u>4588</u>		

Loc. in Sec. C NE NE
 Geol. _____
 Contr. _____
Sierra Drlg.
 Pool _____
Wildcat
 JUN 18 '58 0
ABANDONED

Date Comm. 5/29/58 Mag - FO
 10" @ 318 Drlg. 2420. JUN 11 '58 DST 4184-
 4219 1hr 140' 06 gem FP 80-115
 BHP 145/30 @ 4219 JUN 18 '58 DST
 4219-60 1hr WB 95' WM
 FP 0-75 BHP 972/70 PST
 (SD) 4463-75 60" 50' WM
 FP 0-24 BHP 1624/20 ran log

D & A