


KANSAS Grant

FORM 51 5M PETROL

Section 29 Township 30 Range 35-W

Well No. #2 L. L. Gilbert

Company United Prod.

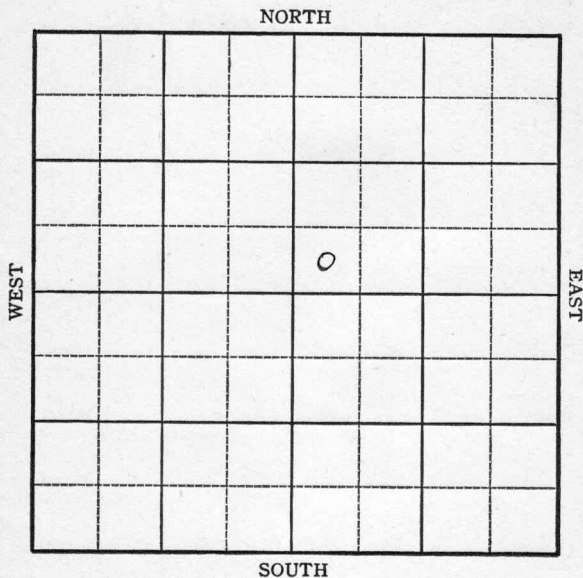

KANSAS

Grant County

Sec. 29 Twp. 30 R. 35W

Well No. #2 L. L. Gilbert Farm

United Prod. Company


Hugoton

 Ft. from N. Line

300 Ft. from S. Line

 Ft. from E. Line

300 Ft. from W. Line

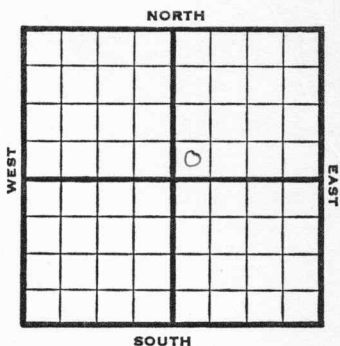

SW NE

Elev. 2901

REPORT

1946

3/6	10" @ 548		
	2020'		
3/14	T.D. 2730'	7" - 2721'	RUST.
3/21	" "	"	
3/28	" "	"	
4/4	" "	"	
4/10	" "	"	
4/16	" "	"	
4/23	" "	"	
5/1	80 shots 2565-2646		
	14000 acid		
5/7	" "	"	
5/12	72 shots 2524-42		
	2000 acid		
5/21	" "	"	
5/29	" "	"	
6/5	7" @ 2722		
	Perf. 11,000 acid.		
	TD 2730'		
	6,436,000 Gas.		
	414# R Pr.		

COMPLETED


KANSASKansas Pool Name HugotonMap No. 10 map Sec. 29 Twp. 30 R. 35WWell No. 2 L. L. GilbertUnited Prod.

Company

FIRST REPORT

Contractor

SW NE

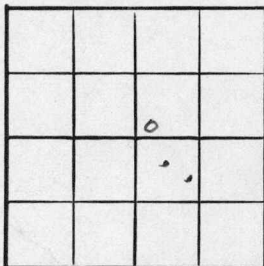SECTION PLAT Ft. from N. Line300 Ft. from S. Line Ft. from E. Line300 Ft. from W. LineGrant CountyLocation Rig up

Drilling and Remarks:

10"-5482020**RECORD**Cased in., ft.Sand Gas Oil Total Depth **PRODUCTION**1st 24 hrs. Nat. 1st 24 hrs. after shot Gas Cu. Ft.Dry Hole Abandoned

Date

MAR 6 194619S. J. LEWISScout

KANSASKansas Pool Name HugotonMap No. ✓ Sec. 29 Twp. 30 R. 35WWell No. 2 L. L. GilbertUnited Prod.

Company

COMPLETED

Contractor

SW NE

E1,2901**SECTION PLAT**

 Ft. from N. Line300 Ft. from S. Line Ft. from E. Line300 Ft. from W. LineGrant CountyLocation Rig up

Drilling and Remarks:

7" C2722Perf.11000 sand6, 436, 000 Gas414 # RPR**RECORD**Cased in., ft.Sand Gas Oil Total Depth 2290**PRODUCTION**1st 24 hrs. Nat. 1st 24 hrs. after shot Gas Cu. Ft.Dry Hole Abandoned

Date

JUN 5 194619S. J. LEWISScout