

Grant


KANSAS

FORM 51 5M PETROL

Section 29 Township 30 Range 36-W

Well No. #1 Hill

Company United Prod.

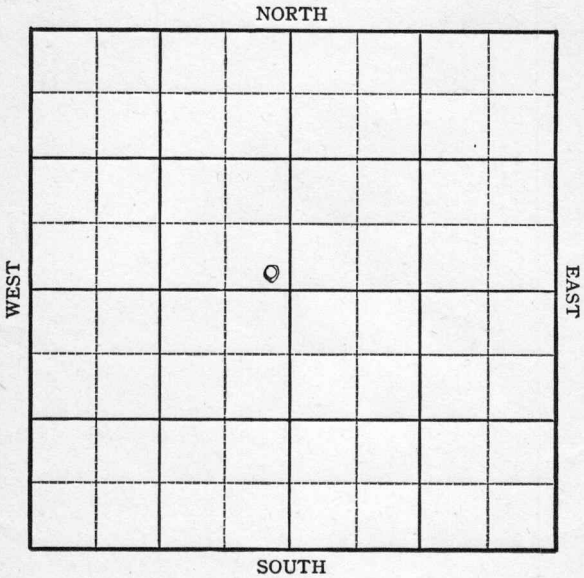

KANSAS

Grant County

Sec. 29 Twp. 30 R. 36W

Well No. #1 Hill Farm

United Prod. Company

Hugoton


Ft. from N. Line

100 Ft. from S. Line

100 Ft. from E. Line

Ft. from W. Line

SE NW

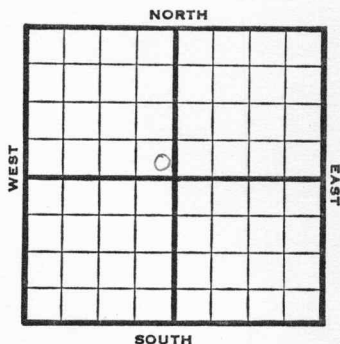

1946 Elev. 3045 REPORT

3/13	RUR		
3/21	10" - 742'		
	Drlg. 1720'		
3/28	Drlg. 2705'		
4/4	TD 2730		
	7" @ 2720 RUST		
4/10	" " "		
4/16	" " "		
4/23	" " "		
5/1	" " "		
5/7	" " "		
5/14	223 shots 2494-2786		
	19000 acid		
5/21	" " "		
5/29	" " "		
6/5	7" @ 2720		
	TD 2730'		
	Perf.		
	19,000 acid.		
	8,260,000 Gas.		
	402# R Pr.		

COMPLETED

KANSAS - KansasPool Name HugotonMap No. None Sec. 29 Twp. 30 R. 36WWell No. 1 HillUnited Prod.

Company

FIRST REPORT

Contractor

SE NW

SECTION PLAT

_____ Ft. from N. Line

100 Ft. from S. Line100 Ft. from E. Line

_____ Ft. from W. Line

Grant County

Location _____

Rig up _____

Drilling and Remarks:

R U R

RECORD

Cased _____ in., _____ ft.

Sand _____

Gas _____

Oil _____

Total Depth _____

PRODUCTION

1st 24 hrs. Nat. _____

1st 24 hrs. after shot _____

Gas _____ Cu. Ft.

Dry Hole _____

Abandoned _____

Date

MAR 13 1946

19

S. J. LEWIS

Scout

KANSAS

Kansas Pool Name Hugoton PoolMap No. Map Sec. 29 Twp. 30 R. 36WWell No. 1 Hill

United Prod.


Company

COMPLETED

Contractor

SE NW

SECTION PLAT

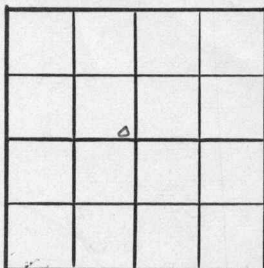

Ft. from N. Line

100 Ft. from S. Line100 Ft. from E. Line

Ft. from W. Line

Grant County

Location

Rig up

Drilling and Remarks:

7'02720

Prof

19000 acid

8,260,000 Gas

402# R P

RECORD

Cased _____ in., _____ ft.

Sand _____

Gas _____

Oil _____

Total Depth 2730

PRODUCTION

1st 24 hrs. Nat. _____

1st 24 hrs. after shot _____

Gas _____ Cu. Ft.

Dry Hole _____

Abandoned _____

Date

JUN 5 1946

19

S. J. LEWIS

Scout