KINGMAN


DX 78-1

KANSAS

Section 29 Township 30S Range 9W

Well No. #1 Cornelius

Company Champlin Ref. Co.

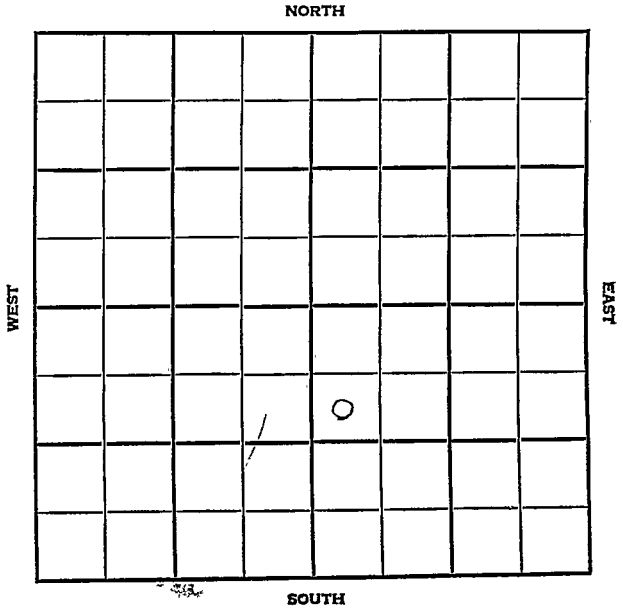

Kingman KANSAS

SEC.	TWP.	R.
29	30S	9W

WELL NO. 1 Cornelius FARM

COMPANY Champlin Refg. Co.

CONTRACTOR

Rochester


_____ FT. FROM N. LINE

_____ FT. FROM S. LINE

_____ FT. FROM E. LINE

_____ FT. FROM W. LINE

SW NW SE

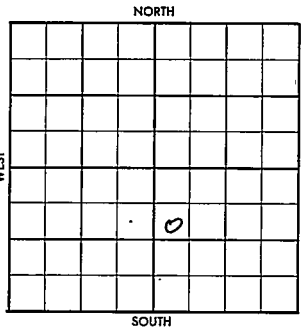

Offset to SDX

1956	ELEVATION 1666	REPORT

6-20 Location

6-28 MIR

7/6 Spud 6-26-56
10" @ 231 w/250
Anhy 890
Drlg 3050

7-12 Heeb. 3455, Doug 3513'; Lans. 3675
Miss. 4335
DST 4346-64, op 2 hrs, gas to surface in 8 min, rec. 30' gcm, 1180/20".
TD 4364'
Running log.

7-19 TD 4422
5½" @ 4421 w/150
CO 60/4350-65, frac.

7-26 F/ 1,250 mcfg, shutin.

8-2 Shutin;

8-9 No report

8-13 No report

8-23 "

8-30 NR

COMPLETED

FORM 504-5 SUNRAY

FORM 513 SUNRAY

County Kingman Elev.

Sec. 29 Twp. 30S Rge. 9W

Company Champlin Ref. Co.

Farm Name Cornelius No. 1


TOPS	DEPTH	LOG	DATUM
Anh.			
T.P.			
H.			
Tr.			
Dg.			
Bl.			
L.			
K.C.			
B.K.C.			
Ce.			
C.			
M.			
M.			
K.			
Mz.			
Mo.			
V.			
S.			
S.			
A			
R.			
P€.			
G.			
T.D.			

Loc. in Sec. SW NW SE

Geol.

Contr.

Pool Rochester

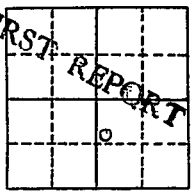

Date Comm. JUN 20 '56

Loc.

Co. Lse. No. Sec. T. R.

FORM 513 SUNRAY

County Kingman Elev. 1636

Sec. 29 Twp. 30S Rge. 9W

Co. Champlin Ref. Co.

Lse. Cornelius No. 1

TOPS	DEPTH	LOG	DATUM
Anh.	890		
Tp.			
H.	3455		
Tr.			
Dg.	3513		
Bl.			
L.	3675		
K.C.			
B.K.C.			
Ce.			
C.			
M.	4344		
M.			
K.			
Mz.			
Mo.			
V.			
S.			
S.			
A			
R.			
Pe.			
G.			
T.D.	4422	4364	

Loc. in Sec. SW NW SE

Geol.

Contr. Armour

Pool Rochester

COMPLETE Oil Well

SEP 12 '56

No.

Sec.

T.

R.

Date Comm.

Loc. JUN 27 '56 MIR JUL 3 '56

7-26-56 10" @ 231 / 250"

Ø 3050 JUL 11 '56 DST 4346-64 2 hrs

9 to 5. 8" TSTM rec 30' GCM

FP 0-100 BHP 1180/20" Rng Log

JUL 18 '56 5½ @ 4421 / 150 co 60/4350

-65 556 Frac JUL 25 '56 F/W 1,250

MCF. S.I. AUG 1 '56 S.I. AUG 8 '56

AUG 15 '56 V AUG 22 '56 S.I. AUG 29 '56

Comp. S.I. Gas well, SEP 12 '56