

Kingman

**KANSAS**

SECTION 29 TOWNSHIP 30 RANGE SW

WELL NO. #1 Carrick

COMPANY N C R A

NORTH NW SE SW


WEST

EAST

SOUTH

Kingman

KANSAS


SEC.	TWP.	R.
29	30 S	8 W

WELL NO. # 1 Carrick FARM

COMPANY N.C.R.A.

CONTRACTOR Beardmore  
Spivey-Grabs

\_\_\_\_\_ FT. FROM N. LINE  
 \_\_\_\_\_ FT. FROM S. LINE  
 \_\_\_\_\_ FT. FROM E. LINE  
 \_\_\_\_\_ FT. FROM W. LINE

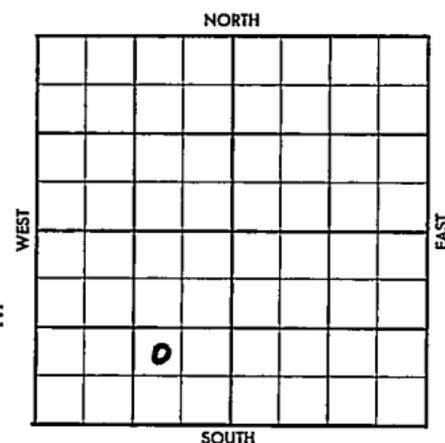

NW SE SW

SDX-1/4 Mile

1957	ELEVATION	REPORT
------	-----------	--------

1/30 Location (FR Tkt)



County Kingman Elev. 1650  
 Sec. 29 Twp. 30 Rge. 8W  
 Company N O R A  
Garrick No. 1

	DEPTH	LOG	DATUM	Loc. in Sec.
				NW SE SW
Tp.				
H.		3349		
Tr.		3364		
Dg.		3382		
Bl.				
L.		3575		
M.C.				Geol.
B.K.C.		4082		Contr.
Ce. <u>Marm</u>		4130		<u>Beardmore</u>
C.				
M.		4307		
M. <u>L1</u>		4344		Pool
K.				<u>Spivey-Grabs</u>
Mz.				
Mo.				
V.				
S.				
A.				
R.				
PE				
G.				
TD	4420			

COMPLETE  
 1/4 M.C.  
 MAR 12 '57

Date Comm.

Location 1-29-57 80/8 225  
1130 @ 3470 FEB 13 '57 DST  
4310-35 1hr G/1" ga 1.141  
MCF 1hr FP 130-130 BHP 1525  
DST 4335-50 1hr G/5" 240 MCF  
110" 285 MCF 1hr net 80' GCM  
F80-110 1520/20 DST 4350-75  
1hr G/5" ga 340 MCF 1hr net  
65' GCM FP 95-110 1615

544 4419/100 FEB 20 '57 CO 4390

136/4308-42 20/4353-58

No test (B) new Ld CP 625#

TP 400# FRAC: 20 X 20

Flow Ld + 2,900 MCFG 2 3/4"

ch CP 1120 TP 820# FEB 22 '57

Est op Flow 10 Mill CFG

MAR 9 '57

MAR 13 '57

F 13 BOPD + 62,490

MCF