Grant

FORM 51 IOM 12-46 PETROL


KANSAS

Section 29 Township 30 Range 38W

Well No. 1 Weeks

Company Stanolind

Hugoton

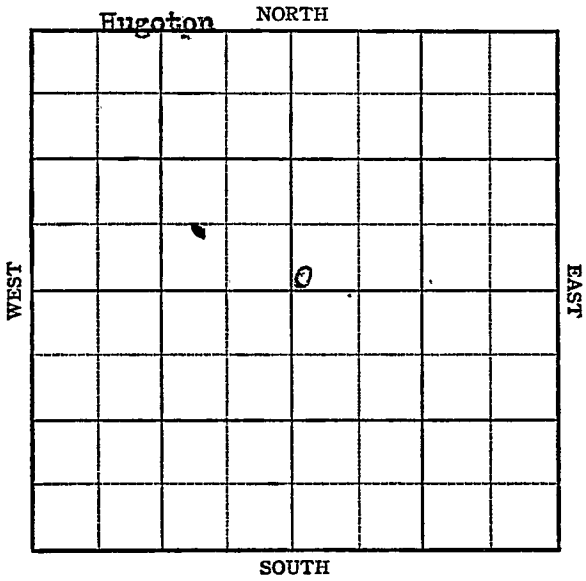

FORM 252-A
5M 9-47 PETROL


Grant

Sec. 29 KANSAS Twp. 30 R. 38W

Well No. #1 Weeks Farm

Stanolind Company

Hugoton

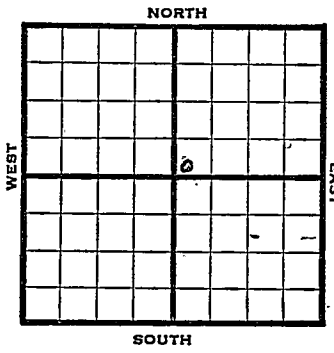

____ Ft. from N. Line

100 Ft. from S. Line

____ Ft. from E. Line

100 Ft. from W. Line

SW NE

1947	Elev. 3141' REPORT
9/10	9" @ 563 6" @ 2414 TD 2430
9/17	Drlg. 2462'
9/24	TD 2643' 15000 Acid
10/1	"
10/8	6" @ 2414' 15,000 Acid 14,996,000 Gas TD 2643' 405# R Pr.
	COMPLETED

Form 26 200 Bks. 10-46 Petrol

Kansas

Hugoton Pool

Map No. _____ Sec. 29 Twp. 30 R. 38W

Well No. 1 Weeks

Stanolind


FIRST REPORT

Company

Contractor

SW NE

SECTION PLAT

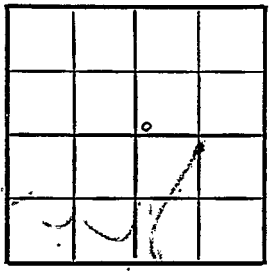

_____ Ft. from N. Line

100 Ft. from S. Line

_____ Ft. from E. Line

100 Ft. from W. Line

Grant County

Location

Rig up

Drilling and Remarks:

9" @ 563

6" @ 2414

TD 2430

RECORD

Cased _____ in., _____ ft.

Sand

Gas

Oil

Total Depth

PRODUCTION

1st 24 hrs. Nat.

1st 24 hrs. after shot

Gas _____ Cu. Ft.

Dry Hole

Abandoned

Date

SEP 10 1947

19

S. J. LEWIS Scout

Hugoton Pool

Form 26 200 Bks. 10-46 Petrol
Kansas

Map No. 0 Sec. 29 Twp. 30 R. 38W

Well No. 1 Weeks

Stanolind Company


COMPLETE

Contractor

SW NE

E 1,314'

SECTION PLAT

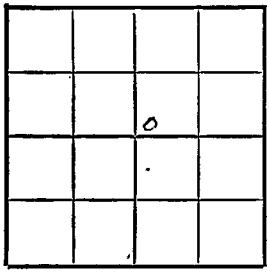

____ Ft. from N. Line

100 Ft. from S. Line

____ Ft. from E. Line

100 Ft. from W. Line

Grant County

Location

Rig up

Drilling and Remarks:

6" @ 2414

1500 acid

14,996,000 Gas

400# RP

RECORD

Cased ____ in., ____ ft.

Sand

Gas

Oil

Total Depth 2643

PRODUCTION

1st 24 hrs. Nat.

1st 24 hrs. after shot

Gas ____ Cu. Ft.

Dry Hole

Abandoned

Date

OCT 8 1947 19

S. J. LEWIS Scout