


SECTION 29 TOWNSHIP 30 RANGE 41WWELL NO. #1 TuckerCOMPANY GrunerwaldNORTH C SE/4th

WEST

EAST

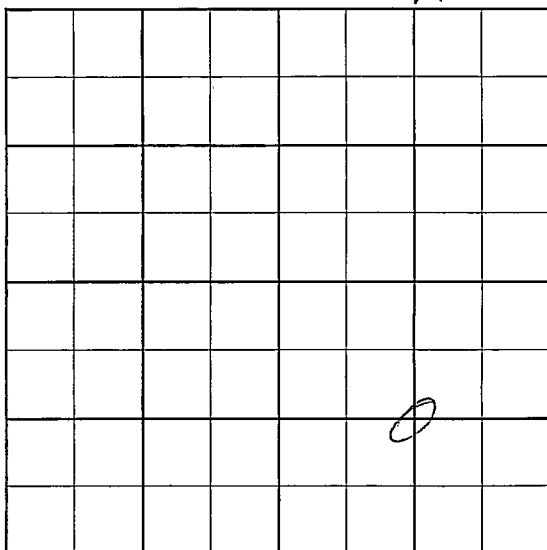

SOUTH

Stanton

KANSAS

SEC.

TWP.

R.

29

30 S

41 W

WELL NO.

1 Tucker

FARM

COMPANY

Grunerwald

CONTRACTOR

Holm Drlg.

____ FT. FROM N. LINE


____ FT. FROM S. LINE

____ FT. FROM E. LINE

____ FT. FROM W. LINE

C SE/4

NORTH

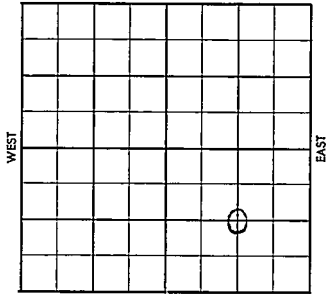

SDX-3/4 mile Superior-FO

ELEVATION

REPORT

1957

8/14

Comm. 8-11-57
Drlg. 1462'

(FR Tkt)

County Stanton Elev. _____
Sec. 29 Twp. 30 Rge. 41W
Company Grunerwald
Farm Name Tucker No. 1

TOPS	DEPTH	LOG	DATUM	Loc. in Sec.
Anh.				C SE/4
TP.				
H.				
Tr.				
Dg.				
Bl.				
L.				
K.C.				Geol. _____
B.K.C.				Contr. _____
Ce.				Holm Drlg.
C.				
M.				Pool
M.				
K.				
Mz.				
Mo.				
V.				
S.				
S.				
A				
R.				
Pe.				
G.				
T.D.				

FIRST REPORT
AUG 14 57
5/4 mile

Date Comm. 8-11-57 Superior - FO
Drlg. 1462

COPIES OF REPORT
1-1-1

County Stanton

Elev.

3429 OFSec. 29Twp. 30Rgs. 41WCompany GrunerwaldFarm Name TuckerNo. 1

TOPS	DEPTH	LOG	DATUM
Anh.			
Tp. <u>W26</u>	<u>2952</u>	<u>3334</u>	
H. <u>TP</u>	<u>3168</u>	<u>3608</u>	
Tr. <u>H6</u>	<u>3201</u>	<u>3636</u>	
Dg.			
BL <u>Elmt</u>		<u>3193</u>	
L. <u>Le Camp</u>		<u>3442</u>	
K.C. <u>Ass</u>		<u>3736</u>	
B.K.C. <u>Man</u>		<u>4253</u>	
Ge. <u>Meat Sh</u>		<u>4933</u>	
C. <u>Meat sd</u>		<u>5152-64</u>	
M. <u>Mt sd 2m</u>		<u>5228</u>	
M. <u>" Pm</u>		<u>5350-54</u>	
* <u>Am</u>		<u>5375</u>	
Mz.			
Mq.			
V.			
S.			
S.			
A.			
R.			
PE.			
G.			
T.D.	<u>5400</u>		


Loc. in Sec. C SE/4

Geol.

Contr.

Holm Drlg.

Pool

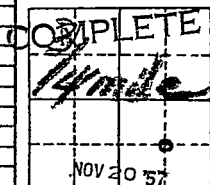Date Comm. 8-11-57 Superior - FODrlg. 1462 3180 8/8 1576/80053 AUG 28 57 4537 SEP 4 57 DST5145-5252 G/2" ga1,200 MCF/15" rec 5' ECM BHT1650/30 TITE REL 11 57DST 5335-60 (hu35" ind FP 0 BHT 200/20"Rm casing SEP 8 57 CO 40/54 52-62

500

1.260 MCF NUTIM ~~250~~ A

Frac 6x3 Est 700 MCF 1hr

~~500~~ WOC SEP 1 57 OCT 2 57 Dec

1.000 MCF SI 5" 5400

OCT 9 57

OCT 16 57

OCT 23 57

1 12 57 4 13 57

NOV 20 57

GA 3 1/2" chlk

234 MCF FCP 1339 for 3 hrs

7 1/2" chlk gas 21 MCF FCP

788 blew 234 hrs

Op L6 POT. 1.045 MCF

mor 5152-62

TD 5400