

3

30

10W


Section _____ Township _____ Range _____

Well No. #1 ~~Libel~~ ^{LIEBL}Company Welsh & Olsson Drlg.

NORTH

WEST

EAST

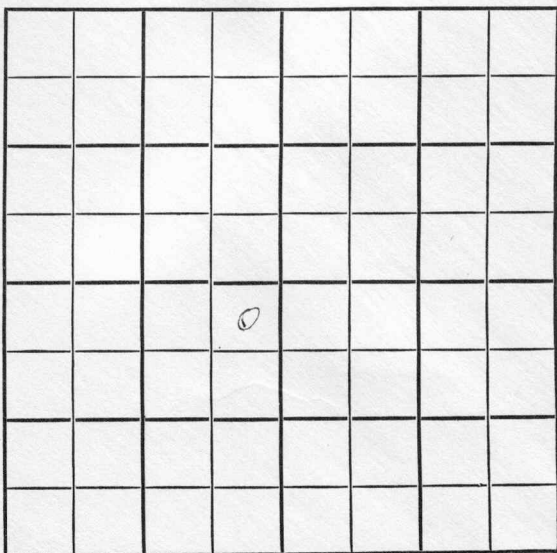

SOUTH

WILDCAT

FORM 513 SUNRAY

County Kingman Elev. _____
 Sec. 3 Twp. 30 Rge. LOW
 Company Welsh & Olsson Drlg.
 Farm Name Libel No. 1

TOPS	DEPTH	LOG	DATUM
Anh.			
Tp.			
H.			
Tr.			
Dg.			
Bl.			
L.			
K.C.			
B.K.C.			
Ce.			
C.			
M.			
M.			
K.			
Mz.			
Me.			
V.			
S.			
S.			
A.			
R.			
Pe.			
G.			
T.D.			

Loc. in Sec. NE NE SW

Geol. _____

Contr. _____

Co. Tools _____

Pool _____

Wildcat



Date Comm. spd. 10-18-56 Magnolia (FO)
8" @ 258 w/200, Drlg. 2620

NOV 5 1956

R. G.

Co.

Lse.

No.

Sec.

T.

R.

Co.

County Kingman Elev. 1698 RB
 Sec. 3 Twp. 30 Rge. 1699D7LOW
 Company Welsh & Olsson Drlg.
 FarmName Liebi Liebi No. 1

TOPS	DEPTH	LOG	DATUM	Loc. in Sec.
Anh.				NE NE SW
Tr.				
H.	3527			
Tr.				
Dg.	3596			
Bl.	3706			
L.	3722			
K.C.				Geol.
B.K.C.				Contr.
Ce.				Co. Tools
C.				
M.	4287			Pool
M.				Wildcat
K.	4385			
Mz.				
Ma.				
V.	4587			
S.	4660			
S.				
A.				
R.				
Pe.				
G.				
T.D.	4685			

Lse.

No.

Sec.

T.

R.

Date Comm. spd. 10-18-56 Magnolia (FO)
8" @ 258 w/200, Drlg. 2620 OCT 31 '56

DST 4274-4300 on 90" res
460' SW (SEC) BHP 1690/30
ahead NOV 7 '56

D & A