
Kingman KANSAS

SECTION 3 TOWNSHIP 30S RANGE 7W

WELL NO. #2 Wulf

COMPANY Pickrell Drlg.

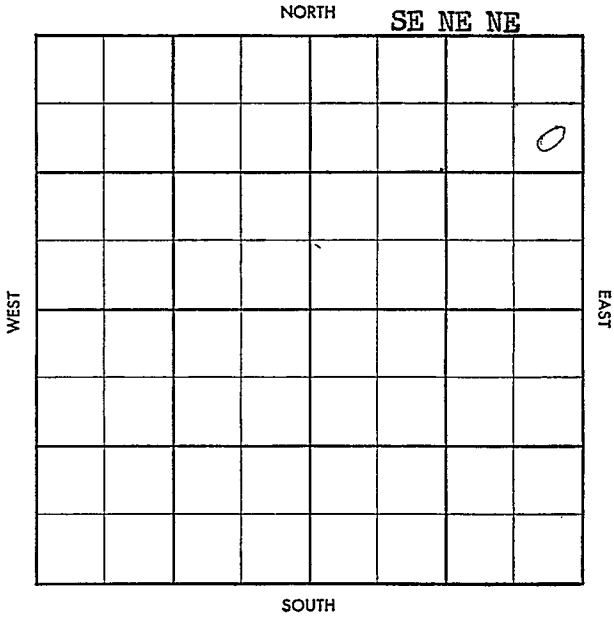

FORM 504-3 SUNRAY

Twp. X Pool

Co. X Feet

S-513-B

County Kingman Elev.

Sec. 3 Twp. 30 Rge. 7W

Company Pickrell Drlg.

Farm Name Wulf No. 2

TOPS	DEPTH	LOG	DATUM
Anh.			
Tp.			
H.			
Tr.			
Dg.			
B.L.			
L.			
K.C.			
B.K.C.			
Ce.			
C.			
M.			
M.			
K.			
Mz.			
Mq.			
V.			
S.			
S.			
A.			
R.			
Pf.			
G.			
T.D.			

Loc. in Sec.

SE NE NE


Geol.

Contr.

Co. Tools #1

Pool

Trenton S.

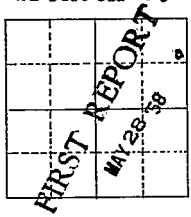

Date Comm.

Location

Co. Lse. No. Sec. T. R.

Twp. V Pool Shimer

Co. X Facst. X

S-513-B

County Kingman Elev. 1495DF 1498RB

Sec. 3 Twp. 30 Rge. 7W

Company Pickrell Drlg.

Farm Name Wulf No. 2

TOPS	DEPTH	LOG	DATUM
Anh.			
Tp.			
H.			
Tr.			
Dg.			
B.L.			
L.			
K.C.			
B.K.C.			
Ce.			
C.			
M.	4110		
M.			
K.			
Mz.			
Mq.			
V.			
S.			
'S.			
A.			
R.			
Pf.			
G.			
T.D.	4210		

Loc. in Sec. SE NE NE

Geol.

Contr. Co. Tools #1

Pool Trenton S.

JUL 30 '58

COMPLETE

Date Comm. 6-29-58

Location JUN 3 '58 8" 260/240 JUN 11 '58 JUN 16 '58 JUN 25 '58 JUL 2 '58 Ø 2300 JUL 9 '58 DST 4113-38 1hr g/3" 700 mcf/5" 1,020 mcf/60" 120 gcm. FP 208-220 BHP 1630-1505 DST 4138-60 JUL 16 '58 90" g/27" TSTM 100 0 gcm 60' gsy CO. BHP 1618-1506 FP 2075 DST 4160-4210

Co. Lse. No. Sec. T. R.

FORM 513-1 SUNRAY

60" 60M FP64-80 BHP
1192 molog 4½ 4209/100
48/9143-55 frac 4½ 4
125A Flo 16 BOph ¾" chk
FCP 750 FTP 420 Flo
42 BO + 80 BW 12 hrs 25/64" ck
TP 350 CP 650 ga 873 mcf
14/64" chk JUL 23 '58 Flo 18.37
BO + 33.36 Bw 9 hrs 16/64 chk
CP 1020 TP 800 venting 900 mcf
1,000 mcf JUL 30 '58 Phy Flo
103 BOpd + 50% w 20/64" chk
CP 935 TP 700 36° gr

3-30-7W

ae nene