Kingman KANSAS

SECTION 30 TOWNSHIP 30 RANGE 9W

WELL NO. #1 Westerman "B"

COMPANY Petroleum Inc.

NORTH

SE SE SE

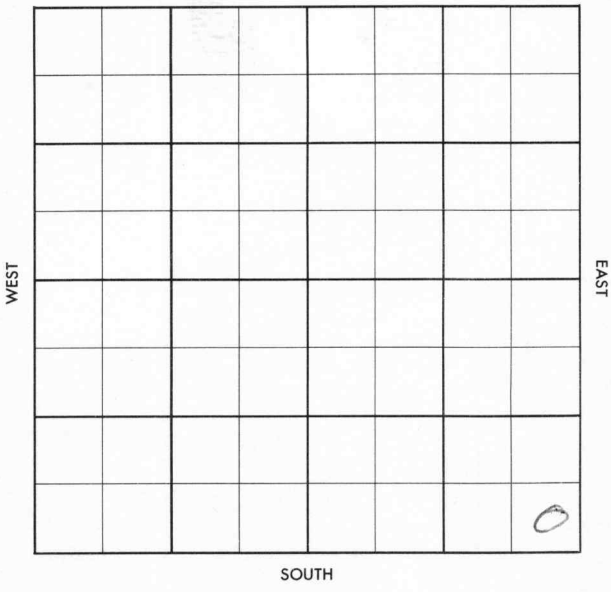

FORM 504-3 SUNRAY

Kingman KANSAS

SEC.	TWP.	R.
30	30 S	9 W

WELL NO.

1 Westerman "B" FARM

COMPANY

Petroleum Inc.

CONTRACTOR

Garvey Tools
Rochester

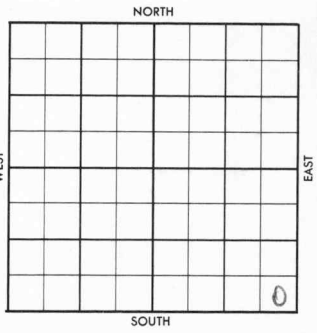

_____ FT. FROM N. LINE

_____ FT. FROM S. LINE

_____ FT. FROM E. LINE

_____ FT. FROM W. LINE

SE SE SE

SDX-Offset

	ELEVATION	
1957	1683' RB	REPORT

6/26 Comm. 6-20-57
8" @ 240/175
Drlg. 2900' (FR Tkt)

FORM 513 SUNRAY

County Kingman Elev. 1683 RB

Sec. 30 Twp. 30 Rge. 9W

Company Petroleum Inc..

Farm Name Westerman "B" No. 1

TOPS	DEPTH	LOG	DATUM
Anh.			
Tp.			
H.			
Tr.			
Dg.			
B.L.			
L.			
K.C.			
B.K.C.			
Ce.			
C.			
M.			
M.			
K.			
Mz.			
Mo.			
V.			
S.			
S.			
A			
R.			
P€.			
G.			
T.D.			

Loc. in Sec. SE SE SE

Geol.

Contr. Garvey Tools

Pool Rochester

SDX - Offset

JUN 26 '57

FIRST REPORT

Date Comm. 6-20-57

8" @ 240/175, Drlg. 2900

27

JUN 28 1957

M. M.

Co. Lse. No. Sec. T. R.

FORM 513 SUNRAY

1681 DF

County Kingman Elev. 1683 RB

Sec. 30 Twp. 30 Rge. 9W

Company Petroleum Inc.

Name Westerman "B" No. 1

	DEPTH	LOG	DATUM
Ami.			
Tp.			
H.	3495		
Tr.	3514		
Dg. Zn	3541		
B.L.			
L.	3708		
K.C.			
B.K.C.	4186		
Ce.			
C.			
M. chert	4376		
M.			
K.			
Mz.			
Mq.			
V.			
S.			
S.			
A			
R.			
PE.			
G.			
T.D.	4476		

Loc. in Sec. SE SE SE

Geol.

Contr. Garvey Tools

Pool Rochester

ABANDONED

JUL 10 57

Lse. No.

Sec.

T.

R.

Date Comm. 6-20-57

8" @ 240/175, Drlg. 2900

DST 4378-4400 1hr rec 30' Md BHP 0/20 JUL 10 57 DST 4400-76 1hr 25' Md BHP 200/20

D & A